

Command= 210-

Point#, Start#-End# or G#= 1-1766

Bearing	Distance	Elev	Descrip	Pnt.	Northing	Easting	Type
-----02-15-2025-----19:11:26-----D:...\BMHOME17							
			SETMAGNL	1	7999.7700	6499.8108	SS
			FNDIPTOP	2	8051.4774	6525.1615	SS
			FNDPK	3	7988.8520	6635.5668	TRA
			FNDPK	4	7930.2311	6578.4565	TRA
			SETMAGNL	5	8151.3073	6719.3151	TRA
			FDDHCB	6	7925.8547	6574.4850	SS
			FNDIP	7	8008.7521	6502.4076	SS
			CORHSE	8	8018.9867	6514.7818	SS
			STEPS	9	8033.1266	6517.4215	SS
			STEPS	10	8042.0042	6521.7444	SS
			CORRTWLL	11	8052.9817	6524.1885	SS
			POLE	12	8097.3732	6546.8800	SS
			FDIPIN	13	8096.0577	6547.8587	SS
			FDIPIN	14	8140.7327	6570.3566	SS
			FNDIP	15	8141.4675	6234.3968	SS
			FNDIPIN	16	8298.1989	5922.0718	SS
			FDDHCB	17	8401.6390	5715.6716	SS
			CORHSE	18	7990.2353	6572.6963	SS
			CORHSE	19	7991.8757	6586.5994	SS
			CORHSE	20	8006.5893	6593.9292	SS
			STEP	21	7992.1245	6556.8692	SS
			STEP	22	8005.7378	6529.4244	SS
			ENDFNC	23	7966.7539	6583.3567	SS
			POLE	24	7961.8137	6593.9087	SS
			FDDHCB	25	7961.7170	6592.3872	SS
			IPINNEW	26	8006.4428	6614.8206	SS
			ENDFNC	27	8021.2835	6586.1363	SS
			STEP	28	8023.9880	6586.0207	SS
			CORBLD	29	8028.6920	6576.1347	SS
			CORBLD	30	8032.7206	6568.1536	SS
			BLKHD	31	8019.8169	6579.4763	SS
			BLKHD	32	8021.5627	6575.9627	SS
			HSE	33	8023.9018	6603.1241	SS
			FNDPK	34	8051.1204	6637.2075	TRA
			FNDPK	35	8095.8017	6659.6600	SS
			FDDHCB	36	8176.2950	6700.0360	SS
			FNDIP	37	8186.5794	6593.1114	SS
			FDDHCB	38	8595.8774	5774.9786	SS
			fndip	39	8051.4907	6525.1577	TRA
			fndip	40	8051.4678	6525.1642	TRA
			setmagnl	41	8006.5975	6503.0103	TRA
			corhse	42	8040.7044	6525.4667	SS
				43	8051.1960	6525.6140	INT
				44	8049.1450	6529.7018	INT
				45	8014.8412	6598.0696	INT
				46	7998.1891	6610.6709	INT

JOB #13 777BAMFORD [1766]

Bearing	Distance	Elev	Descrip	Pnt.	Northing	Easting	Type
-----02-15-2025-----19:11:26-----D:...\BMHOME17							
				47	7983.4967	6603.2989	INT
				48	8033.5685	6516.5407	INT
				49	8042.3934	6520.9686	INT
			KIMCHS	50	8401.6340	5715.6960	
			KIMCHS	51	8176.2950	6700.0360	
			KIMCHS	52	7961.7510	6592.3880	
			KIMCHS	53	8595.6960	5774.8930	
			KMCHS	54	8140.5110	6682.0810	
			knchs	55	8006.4410	6614.8113	TRA
			kmchs	56	8051.1310	6637.2345	SS
			kmchs	57	8095.8210	6659.6578	SS
			kmchs	58	7925.9670	6574.4330	TRA
			kmchs	59	8006.5977	6503.0080	TRA
			kmchs	60	8051.2877	6525.4313	SS
			kmchs	61	8095.9777	6547.8546	TRA
			kmchs	62	8140.6677	6570.2778	SS
				63	8004.3700	6507.4478	INT
				64	7995.8360	6524.4562	INT
				65	7982.0971	6551.8379	INT
				66	7975.3730	6565.2391	INT
				67	8023.2948	6581.2214	INT
				68	8025.0544	6577.7146	INT
				70	8020.9202	6585.9540	INT
			setmagnl	71	7923.2647	6069.6126	TRA
			setip	72	8038.3934	6127.3828	SS
			setip	73	7949.0149	6082.5556	SS
			fndipin*	74	7792.2722	6395.4259	SS
			setip	75	7949.0084	6082.5448	SS
			setip	76	7926.5794	6127.2124	SS
			setmagnl	77	8015.9627	6172.0615	SS
				78	7792.0536	6395.3600	TRA
			kc	80	8355.0550	6789.7300	
			kc	81	8828.6040	5845.9400	
			kc	82	8634.5430	5786.7430	
			kc	83	8168.7250	5644.6490	
			kc	84	8362.7870	5703.8460	
			kc	85	7925.9670	6574.4330	
			kc	86	7747.2070	6484.7400	
			kc	87	7935.8160	5573.6020	
			kc	88	8129.8780	5632.7990	
			kc	89	7711.4230	6466.7850	
			kc	90	7532.6630	6377.0920	
			kc	91	7702.8510	5502.5380	
			kc	92	7896.9130	5561.7350	
			kc	93	7496.8270	6359.1110	
			kc	94	7318.0670	6269.4180	
			kc	95	8867.4510	5857.7900	
			kc	96	9061.5130	5916.9870	
			kc	97	8569.5990	6897.3780	
			kc	98	8390.8390	6807.6840	
			calcor	99	7926.5936	6127.2201	TRA
	16.86		3MAGNAIL	100	8151.3073	6719.3151	OCC
	9.55		2SETPK	101	8442.7639	6100.9424	TRA
	10.63		1SETHUB	102	8561.8331	6159.9583	TRA
	9.32		5SETPK	103	8678.0367	6221.5816	TRA
	14.92		4FNDPK	104	8364.2062	6791.1348	TRA
	16.86		POLE	105	8536.2490	6211.0954	SS
			FNDIPIN*	106	8490.3312	6297.2780	SS

JOB #13 777BAMFORD [1766]

Bearing	Distance	Elev	Descrip	Pnt.	Northing	Easting	Type
-----02-15-2025-----19:11:26-----D:... \BMHOME17							
			OFFSET	107	8467.7736	6342.4099	SS
			FNDIPIN*	108	8467.9514	6342.5015	TRA
			CORHSE	109	8542.3576	6146.4177	SS
			CORHSE	110	8550.6652	6129.4799	SS
			DECK	111	8555.6614	6118.4849	SS
			@FNC**	112	8540.3299	6099.1800	SS
			SHED	113	8565.8227	6126.0723	SS
			SHED	114	8572.5839	6129.6590	SS
			SHED	115	8577.5309	6120.2054	SS
			4X4**	116	8535.4219	6154.0225	SS
			CORWLL	117	8557.3928	6163.5324	SS
			SETNL***	118	8557.0679	6163.9870	SS
			FNDNL***	119	8580.3462	6119.5251	SS
			FNDIPIN*	120	8467.5191	6566.9954	SS
			FNDIPIN*	121	8557.5341	6387.5983	SS
			FNDIPIN*	122	8580.0174	6342.9414	SS
			ENDWLL**	123	8648.7854	6211.5921	SS
			ENDFNC**	124	8673.8212	6166.2218	SS
			BOLLRD**	125	8823.7150	5851.5663	SS
			6setspk	126	8835.5337	5811.9350	TRA
			FNDIPIN	127	8737.7019	6029.1283	SS
			FNDDHCB	128	8634.5476	5786.8939	SS
			FNDPIN?*	129	8595.8558	5774.9154	SS
			SETPK	130	8130.6369	5637.6212	SS
			FNDIP***	131	7896.7101	5563.0640	SS
			CORFNC	132	8460.8782	6124.4157	SS
			CORHSE	133	8488.4879	6120.3953	SS
			CORHSE	134	8497.7501	6102.1740	SS
			CORWLL	135	8455.5409	6056.7109	SS
			CORWLL	136	8500.2467	5967.2352	SS
			DHCBCHK	137	8634.5059	5786.9007	SS
			CRCONC	138	8439.7564	6166.5836	SS
			ENDFNC	139	8405.0491	6255.3327	SS
			ENDFNC	140	8381.4618	6299.9026	SS
			ENDFNC	141	8359.5411	6344.5596	SS
			CORCHLK	142	8353.5795	6258.8359	SS
			ENDWL**	143	8374.3865	6217.8665	SS
			CORCONC*	144	8492.2785	6071.4548	SS
			FNDNLPOL	145	7712.0903	6468.6942	SS
			FNDDH**	146	7711.4064	6466.8090	SS
			FNDDHCB	147	7747.1956	6484.8791	SS
			FNDPKCAR	148	7930.2289	6578.4545	SS
			DHCBCHK	149	8176.3123	6700.0266	SS
			CORWLL	150	8355.7576	6790.0780	SS
			FNCCB***	151	8390.5771	6808.2974	SS
			FDNLPOL	152	8390.7433	6809.2522	SS
			KC	153	8605.3300	6915.3060	
			KC	154	9100.3030	5928.8190	
			KC	155	9294.3640	5988.0160	
			KC	156	8784.0900	7004.9990	
			KC	157	9333.1540	5999.8480	
			KC	158	9527.2150	6059.0450	
			KC	159	8819.8212	7022.9272	INT
				160	8151.3073	6719.3151	OCC
				161	8442.7657	6100.9385	TRA
				162	8561.8239	6159.9524	TRA
				163	8678.0152	6221.5549	TRA
				164	8364.2266	6791.1301	TRA

JOB #13 777BAMFORD [1766]

Bearing	Distance	Elev	Descrip	Pnt.	Northing	Easting	Type
-----02-15-2025-----19:11:26-----D:...\BMHOME17							
				165	8151.3073	6719.3151	TRA
				166	8810.3206	7028.5281	INT
			KC	167	9254.9797	6066.5095	TRA
	16.86		3kochman	170	8151.3073	6719.3151	OCC
	19.91		fnddh	171	7711.4113	6466.7634	TRA
	8.84		2setpk	172	7903.4790	6110.8296	TRA
	9.34		3pkwolf	173	8130.6051	5637.6197	TRA
	10.06		6spkkoch	174	8835.5338	5811.9329	TRA
	9.32		5kochpk	175	8678.0389	6221.5845	TRA
	14.92		4kochpk	176	8364.2107	6791.1416	TRA
	19.76		jbtbm135	177	7535.7176	6418.8114	SS
	12.77		jbtbm129	178	8310.6601	5687.5134	SS
			corbrkwl	179	7740.6228	6410.2125	SS
			fdpinpsa	180	8023.0554	5558.3438	SS
			fdpinpsa	181	7975.2244	5543.7777	SS
			2"ipbnt	182	8166.1639	5647.2125	SS
			fndip**	183	8129.2805	5724.5597	SS
			fndip**	184	8102.8658	5777.1899	SS
			fndpk	185	8039.1346	5903.8124	SS
			endfnc**	186	8074.4820	5753.7269	SS
			endfnc/w	187	8081.7900	5738.6330	SS
			endwll**	188	8128.4121	5647.3251	SS
			fndpk	189	8054.4511	5853.0100	SS
			tripip**	190	8016.8729	5948.7231	SS
			endfnc**	191	7993.7714	5992.9838	SS
			endfnc**	192	7975.2929	6029.4702	SS
			endfnc**	193	7971.9100	6038.1576	SS
			endfnc**	194	7963.2735	6056.4115	SS
			endfnc**	195	7951.3153	6083.3047	SS
			corfnc**	196	7935.2235	6031.1181	SS
			corfnc**	197	7917.9387	6065.7835	SS
			endfnc**	198	7895.5595	6109.2273	SS
			ipbent**	199	7869.4447	6154.2254	SS
			fndip***	200	7846.8154	6199.0852	SS
			ipincote	201	7814.7177	6349.9468	SS
			ipincote	202	7836.8511	6304.9961	SS
			endfnc**	203	7882.2039	6216.0197	SS
			endfnc**	204	7906.3559	6172.5826	SS
			pole13/6	205	8018.0445	6169.8400	SS
			fndipin	206	8016.4500	6171.9181	SS
			chim**	207	7993.4796	6152.0955	SS
			corhse	208	7959.9311	6105.9804	SS
			step**	209	7928.3162	6153.0452	SS
			step**	210	7923.4021	6153.3649	SS
			ffl	211	7925.0239	6158.1344	SS
			corhse	212	7948.7834	6127.8327	SS
			calcor	213	8467.7986	6119.0664	TRA
			calcor	214	8490.2219	6074.3764	TRA
			calcor	215	8646.5581	6208.7602	SS
			calcor	216	8668.9814	6164.0702	TRA
			calcor	217	8579.6017	6119.2233	TRA
			calcor	218	8557.1782	6163.9132	TRA
			calcor	219	8540.1943	6099.4504	INT
			calcor	220	8471.4270	6111.8350	INT
			calcor	221	8484.8594	6127.6268	INT
			calcor	222	7926.5936	6127.2201	TRA
			calcor	223	7949.0169	6082.5302	TRA
			calcor	224	8105.3538	6216.9132	TRA

JOB #13 777BAMFORD [1766]

Bearing	Distance	Elev	Descrip	Pnt.	Northing	Easting	Type
-----02-15-2025-----19:11:26-----D:...\BMHOME17							
			calcor	225	8127.7771	6172.2233	TRA
			calcor	226	8038.3969	6127.3767	TRA
			calcor	227	8015.9737	6172.0667	TRA
			calcor	228	7836.5870	6529.5865	TRA
			calcor	229	7993.4796	6152.0955	INT
			calcor	230	7989.9984	6159.0336	INT
			calcor	231	7944.5661	6136.2378	INT
			calcor	232	7930.8109	6118.8150	INT
				235	8016.2947	6172.2277	INT
				236	7951.1636	6083.6072	INT
				237	7949.0169	6082.5302	INT
				238	7923.2638	6069.6085	INT
			kc	239	9718.5831	6221.9696	TRA
			kc	240	9814.2319	6251.1466	TRA
			kc	241	9733.1716	6174.1452	TRA
				242	9685.8798	6107.4446	INT
				243	9707.8105	6258.2604	TRA
				244	9434.3198	6333.3798	INT
				245	9692.0465	6221.8367	INT
				246	9421.7490	6383.0611	INT
				247	9375.9205	6403.0548	TRA
				248	9422.1926	6382.9370	TRA
				249	9375.4986	6402.0838	TRA
				250	9562.9673	6076.9831	TRA
			kc	251	9566.0273	6070.8844	INT
			kc	252	9709.5006	6114.6499	TRA
			kc	253	9680.3235	6210.2988	TRA
			kc	254	9520.5328	6161.5557	INT
			kc	255	9499.6613	6203.1531	TRA
			kc	256	9632.4991	6195.7102	TRA
			kc	257	9584.6747	6181.1217	TRA
			kc	258	9538.5244	6167.0439	TRA
			kc	259	9578.2435	6258.8175	TRA
			kc	260	9434.3198	6333.3798	TRA
			kc	261	9582.7173	6269.1540	INT
			kc	262	9536.8228	6289.0169	INT
			kc	263	9674.4855	6229.4370	INT
			kc	264	9469.4706	6174.1307	TRA
			kc	265	9431.4742	5803.8941	INT
			kc	266	9424.7806	6151.7074	TRA
			kc	267	9290.7106	6084.4376	TRA
			kc	268	9156.1709	6352.5776	TRA
			kc	269	9295.8003	6422.6369	TRA
			kc	270	9088.9011	6486.6476	TRA
			kc	271	9173.7227	6529.2070	TRA
			50	272	9155.2740	6350.7900	TRA
			kc	273	9133.7476	6397.2676	TRA
			kc	274	9255.1078	6458.1603	TRA
			kc	275	9173.7227	6529.2070	TRA
			kc	276	8984.7898	6694.1433	TRA
			kc	277	9450.2075	6370.0892	TRA
			kc	278	9200.0282	6559.3404	TRA
			kc	279	9383.9886	6398.7486	INT
			kc	280	8937.3858	6788.6193	INT
			kc	281	9747.7601	6126.3207	TRA
			kc	282	9707.3483	6258.7997	INT
			kc	283	9382.9589	6346.5502	INT
			kc	284	9447.0473	6218.8207	TRA

JOB #13 777BAMFORD [1766]

Bearing	Distance	Elev	Descrip	Pnt.	Northing	Easting	Type
-----02-15-2025-----19:11:26-----D:...\BMHOME17							
			kc	285	9424.6240	6263.5107	TRA
			kc	286	9402.2007	6308.2007	TRA
			kc	287	9377.1604	6351.6120	TRA
			kc	288	9178.5942	6307.8876	TRA
			kc	289	9201.0174	6263.1976	TRA
			kc	290	9223.4407	6218.5076	TRA
			kc	291	9245.8640	6173.8176	TRA
			kc	292	9268.2873	6129.1276	TRA
			kc	293	9290.7106	6084.4376	TRA
			kc	294	9380.0906	6129.2841	TRA
			kc	295	9357.6673	6173.9742	TRA
			kc	296	9335.2440	6218.6642	TRA
			kc	297	9312.8207	6263.3542	TRA
			kc	298	9290.3975	6308.0442	TRA
			kc	299	9267.9742	6352.7342	TRA
			1SETMAGN	300	8809.5269	7030.2141	
			2SETMAGN	301	8838.9533	6910.4151	TRA
			FNDMAGNL	302	8151.3073	6719.3151	SS
			FNDDHCB	303	8569.7439	6897.3556	SS
			FNDIPIN	304	8954.6622	7090.8953	SS
			FDPINERN	305	8985.7316	7148.6516	SS
			FNDIP	306	8806.0365	7060.7351	SS
			CORWLL	307	8863.9443	7045.9613	SS
			CORWLL	308	8818.7840	7023.2568	SS
			CORWLL	309	8842.5856	6975.1448	SS
			3PK	310	8881.4062	6821.6635	SS
			FNDIP	311	8873.8174	6826.0052	SS
			FDRRSPK	312	9118.1959	6333.8590	SS
			FNDIP	313	9164.8465	6245.3140	SS
			FNDIPIN	314	9232.5209	6111.1638	SS
			FNDIPIN	315	9255.0064	6066.4947	SS
			4SETHUB	316	9030.1072	6921.9235	TRA
			BNTIPP*	317	8828.8438	6915.6883	SS
			CLWLL**	318	8953.7472	6921.9557	SS
			CLWLL**	319	8999.3258	6944.9316	SS
			CLWLL<	320	9033.3676	6961.5295	SS
			CLWLL<	321	9035.0339	6908.7870	SS
			CLWLLCOR	322	8985.4808	6883.1159	SS
			CORHSE	323	8982.5383	6891.1226	SS
			CLSTP**	324	8981.3120	6906.4166	SS
			EDGRF*	325	8982.7098	6889.9743	SS
			CORHSE	326	8969.7825	6916.4777	SS
			CORRF	327	8968.9476	6917.4909	SS
			CORWLL**	328	9062.9148	6829.1750	SS
			CORWLL*	329	8784.0741	6894.3939	SS
			IBAR@WL*	330	8740.7458	6872.5621	SS
			CORWLCL*	331	8888.2759	6889.0027	SS
			CORHSE	332	8919.4015	6891.2481	SS
			corwll	333	8910.4262	6845.1915	SS
			***WLL	334	8910.8889	6844.3322	SS
			CLWL**	335	8936.2523	6857.6533	SS
			INTSMS**	336	8944.6473	6861.8328	SS
			INTSMS**	337	8954.4894	6866.8039	SS
			ENDSM**	338	8964.7657	6871.8868	SS
			CORHSE	339	8932.0721	6865.8241	SS
				340	8910.4372	6845.2244	TRA
			mark	341	9068.6139	6923.5259	SS
			hightide	342	9094.7094	6901.3799	SS

JOB #13 777BAMFORD [1766]

Bearing	Distance	Elev	Descrip	Pnt.	Northing	Easting	Type
-----02-15-2025-----19:11:26-----D:...\BMHOME17							
			hightide	343	9065.0200	6908.2634	SS
			hightide	344	9071.4719	6933.5957	SS
			hightide	345	9075.6128	6948.7412	SS
			setip	346	9065.8617	6978.5503	SS
			setdh	347	9068.5943	6923.9954	TRA
			kc	348	9245.5509	6397.4242	INT
			kc	349	9661.6762	6100.0614	TRA
			kc	350	9613.8517	6085.4729	TRA
				351	9507.7498	6454.7384	TRA
				352	9467.6776	6363.0647	INT
	100			353	9511.4158	6453.1384	TRA
				354	9599.4012	6414.7382	TRA
				355	9559.4995	6322.9901	INT
				356	9605.3251	6302.9897	TRA
				357	9645.2269	6394.7381	TRA
				358	9718.5480	6362.7379	TRA
	50			359	9601.6591	6301.3897	TRA
				360	9651.1508	6282.9896	TRA
				361	9766.6440	6306.7010	TRA
	50			362	9647.4848	6281.3896	TRA
				363	9696.9765	6262.9895	TRA
				364	9288.6052	6479.5389	INT
				365	9376.1347	6403.0180	TRA
				366	9416.0840	6494.7056	TRA
				367	9288.6364	6479.6322	TRA
				368	9354.5128	6554.8672	TRA
				369	9319.4206	6449.5528	TRA
				370	9332.2727	6441.4239	TRA
				371	9385.2970	6524.7878	TRA
				372	9251.0189	6512.5704	TRA
				373	9175.7839	6578.4468	TRA
				374	9241.6603	6653.6818	TRA
				375	9062.9924	6677.2079	INT
				376	9025.2240	6710.2783	INT
				377	9110.8633	6808.0838	TRA
				378	8987.6964	6743.1377	TRA
				379	9083.2172	6852.2284	TRA
				380	9075.8579	6888.3871	TRA
				381	8942.5554	6782.6635	TRA
				382	9079.3133	6888.6802	INT
				383	9295.8310	6422.6101	INT
				384	9430.1845	6029.4465	TRA
				385	9366.9153	6346.4675	INT
				386	9351.1107	6374.3529	INT
				387	8999.7429	6681.0896	INT
			KC	388	9097.9956	6379.3290	TRA
			KC	389	9098.0164	6379.3394	INT
			kc	390	9120.4397	6334.6495	TRA
			int	391	8815.1681	7020.5925	INT
			int	392	8883.0720	6886.7809	INT
			int	393	9295.8003	6422.6369	INT
			int	394	9295.1929	6422.3321	INT
			int	395	9389.4206	6301.7882	INT
			int	396	9384.6064	6338.7032	INT
				397	9250.0356	6388.4862	TRA
				398	9300.2850	6413.6989	TRA
				399	9317.1562	6326.8889	TRA
			kc	400	8828.9366	6915.6190	TRA

JOB #13 777BAMFORD [1766]

Bearing	Distance	Elev	Descrip	Pnt.	Northing	Easting	Type
-----02-15-2025-----19:11:26-----D:...\BMHOME17							
			kC	401	8873.7833	6826.2391	TRA
			kC	402	9120.4398	6334.6492	TRA
			kC	403	9165.2865	6245.2693	TRA
			kC	404	9232.5564	6111.1993	TRA
			kC	405	8953.8912	7090.1970	TRA
			kC	406	8813.5650	7045.7308	INT
			kC	407	8823.9638	7025.0057	INT
			kC	408	8954.7870	7090.6465	INT
			kC	409	8864.6679	6933.5472	TRA
			kC	410	8998.7379	7000.8170	TRA
			kC	411	9085.0790	7044.1388	SS
			kC	412	8887.0912	6888.8572	TRA
			kC	413	8931.7812	6911.2805	TRA
			kC	414	9065.8512	6978.5503	TRA
			kC	415	9090.8776	6991.1074	TRA
			kC	416	9090.8784	6991.1058	TRA
			kC	417	8909.5145	6844.1672	TRA
			kC	418	9068.6109	6923.9941	TRA
			kC	419	8938.6648	6786.0703	TRA
			kC	420	9079.3133	6888.6802	INT
			kC	421	8984.7898	6694.1427	TRA
			kC	422	9011.0956	6724.2758	TRA
			kC	423	8939.5613	6786.7243	INT
			kC	424	8984.7610	6747.2656	TRA
			kC	425	9080.1196	6856.4980	TRA
			kC	426	9088.9012	6486.6471	TRA
			kC	427	9173.7243	6529.2051	TRA
			kC	428	9173.7229	6529.2064	TRA
			kC	429	9084.8343	6852.1956	INT
			kC	430	9062.8962	6829.1928	INT
			kC	431	9059.1421	6832.4685	INT
			kC	432	9080.4263	6889.0369	INT
			kC	433	9084.8343	6852.1956	INT
			kC	434	9084.6422	6852.3785	INT
			kC	435	9062.8962	6829.1928	INT
			kC	436	7035.8220	5152.6970	
			kC	437	7229.8740	5211.8910	
			kC	438	7171.3940	5668.4510	
			kC	439	6973.0150	5643.0410	
			kC	440	6967.9330	5682.7170	
			kC	441	7166.3120	5708.1270	
			kC	442	7140.9020	5906.5060	
			kC	443	7119.4920	5962.8340	
			kC	444	6793.2460	5078.7020	
			kC	445	6987.2980	5137.8960	
			kC	446	6923.4090	5636.6910	
			kC	447	6725.0300	5611.2810	
			kC	448	6744.7040	5063.9990	
			kC	449	6675.4170	5604.9290	
			kC	450	6477.0380	5579.5190	
			kC	451	6548.9320	5018.2290	
			kC	452	6499.5380	5010.2630	
			kC	453	6429.1350	5559.9090	
			kC	454	6230.7560	5534.4990	
			kC	455	6300.2170	4992.2020	
			kC	456	6423.1950	5614.9520	
			kC	457	6410.6630	5714.1640	
			kC	458	6249.9700	4991.1570	

JOB #13 777BAMFORD [1766]

Bearing	Distance	Elev	Descrip	Pnt.	Northing	Easting	Type
-----02-15-2025-----19:11:26-----D:... \BMHOME17							
			kc	459	6178.0120	5552.9470	
			kc	460	5979.6320	5527.5370	
			kc	461	6047.0450	5001.2390	
			kc	462	6212.2390	5689.0990	
			kc	463	6224.7720	5589.8870	
				464	9283.1722	6356.5832	TRA
				465	9378.0833	6350.9061	INT
				466	9378.0750	6351.1458	INT
				467	9320.9710	6451.3198	INT
				468	9333.0488	6217.2982	TRA
				469	9289.6361	6307.0655	TRA
				470	9245.0357	6396.9358	TRA
				471	9245.0548	6396.8977	INT
				472	9245.9741	6397.3482	TRA
				473	9296.2528	6422.5026	TRA
				474	9245.1897	6396.6298	TRA
				475	9289.6448	6307.0545	TRA
				476	9376.3953	6350.6751	INT
				477	9290.2388	6307.3517	TRA
				478	9290.6325	6307.5515	INT
				479	9245.0357	6396.9358	TRA
				480	9326.8589	6326.5034	TRA
				481	9245.0958	6396.8159	TRA
				490	9376.5676	6350.8712	TRA
				491	9318.9150	6322.3642	INT
				492	9747.9464	6125.7035	TRA
				493	9527.3028	6058.7563	TRA
			durgcal	494	9402.3149	6307.8180	TRA
				495	9376.5676	6350.8712	TRA
				496	9383.9452	6338.5347	INT
				497	9245.6435	6397.2392	TRA
				498	9295.9450	6422.3479	TRA
				499	9377.2835	6351.2983	TRA
			FNDPK	500	7807.2023	6343.5694	
			MAGNL238	501	7923.2853	6069.6299	TRA
			PKBROKE	502	7903.4879	6110.8410	SS
			PKPORTS	503	8130.6250	5637.6413	SS
			PINCHK	504	7836.8726	6304.9891	SS
			FNDPK	505	7827.8354	6303.2300	SS
			DHCORWL	506	7711.4183	6466.7645	SS
			FNDPK	507	7783.4151	6388.0482	SS
			IPINC&S	508	7792.1012	6395.3733	SS
			IPINERN	509	7904.0260	6394.3886	SS
			INTFNCS	510	7904.5864	6393.8535	SS
			CORSHD**	511	7894.7438	6399.4195	SS
			CORSHD**	512	7885.4782	6395.3268	SS
			CORHSE**	513	7880.9822	6393.8431	SS
			CORPOST	514	7839.8912	6361.8229	SS
			CORHSETR	515	7828.8016	6367.8402	SS
			CORHSETR	516	7817.6214	6390.5069	SS
			PKBROKE	517	7903.4919	6110.8481	SS
			PKCHK	518	7827.8466	6303.2201	SS
			PKCHK	519	7807.2085	6343.5501	SS
			PINCHK	520	7814.7349	6349.9363	SS
			DHCORWLL	521	7711.4113	6466.7634	SS
			DHCNCBD	522	7747.1807	6484.8382	SS
			IPINC&S	523	7836.8607	6417.8029	SS
			ENDPST**	524	7838.6602	6417.8694	SS

JOB #13 777BAMFORD [1766]

Bearing	Distance	Elev	Descrip	Pnt.	Northing	Easting	Type
-----02-15-2025-----19:11:26-----D:...\BMHOME17							
			ENDPST**	525	7794.8177	6396.5446	SS
			POLE	526	7883.0979	6439.0226	SS
			CORFND**	527	7869.6873	6416.4275	SS
			CORFND**	528	7817.7928	6390.4281	SS
			OFFSET	529	7810.8184	6405.5213	SS
			DHCHK	530	7711.4113	6466.7634	SS
			POLE	531	7811.2647	6404.8214	TRA
			DHCHK	532	7711.4233	6466.7683	SS
			POLE	533	7927.5025	6351.1760	SS
			PINERNIE	534	7926.3102	6349.7732	SS
			pol	535	7841.1637	6532.9925	TRA
			pol	536	7838.4916	6531.6285	TRA
			pol	537	7835.8196	6530.2646	TRA
			pol	538	7833.1476	6528.9007	TRA
			int	539	7836.1598	6530.4382	INT
			kc	540	7792.0536	6395.3600	TRA
			kc	541	7814.4770	6350.6701	TRA
			kc	542	7970.8137	6485.0531	TRA
			kc	543	7993.2370	6440.3631	TRA
			kc	544	7903.8570	6395.5166	TRA
			kc	545	7881.4337	6440.2065	TRA
			KC	546	7836.5871	6529.5866	TRA
			KC	547	7791.8971	6507.1633	TRA
			KC	548	7836.7437	6417.7833	TRA
			setpklc	549	7836.5843	6529.5846	SS
			fdcapC&S	550	7792.0202	6507.1652	SS
			4pk	551	7930.2409	6578.4482	SS
			4pk	552	7930.2672	6578.4544	SS
			setip	553	7881.4413	6440.1880	SS
			setip	554	7903.8648	6395.5205	SS
				555	9290.4516	6307.8399	INT
				556	9290.4056	6307.9320	TRA
				557	9384.5575	6338.6631	INT
				600	7862.5182	6430.7157	INT
				601	7810.6392	6404.6854	INT
				602	7799.2073	6381.1027	INT
				603	7888.6028	6425.9185	INT
			pinchk	604	9421.9777	6383.0132	SS
			pinchk	605	9461.9158	6474.7387	SS
			setrrspk	606	9376.5624	6350.8929	SS
			pmovibar	607	9402.5915	6307.5604	SS
			pole	608	9376.4204	6400.1525	SS
			spkchk	609	9327.1736	6329.0604	SS
			endfnc*	610	9324.5952	6325.1992	SS
			endfnc*	611	9363.7115	6335.5221	SS
			728chk	612	9295.3114	6422.0598	SS
			endchlk	613	9251.8165	6456.6474	SS
			endchlk	614	9209.8160	6492.6627	SS
			corchlk	615	9250.5814	6511.7929	SS
			endchlk	616	9288.3104	6478.8039	SS
			bkendcrb	617	9314.5757	6404.9629	SS
			corhse**	618	9439.4981	6405.0511	SS
			<ep	619	9369.5456	6351.8726	SS
			endchlk	620	9401.0397	6306.8347	SS
			h20gt	621	9376.4693	6357.9723	SS
			h20gt	622	9380.5470	6361.9125	SS
			smh	623	9378.0583	6374.5042	SS
			cbasin	624	9386.1711	6385.0912	SS

JOB #13 777BAMFORD [1766]

Bearing	Distance	Elev	Descrip	Pnt.	Northing	Easting	Type
-----	-----	-----	-----	-----	-----	-----	-----
		02-15-2025		19:11:26			D:... \BMHOME17
			hse	625	9245.0663	6407.9939	SS
			setip**	626	9245.0609	6396.9017	SS
			corprch	627	9257.5603	6416.7213	SS
			corbld	628	9245.0448	6408.0016	SS
			corstps	629	9232.5572	6377.9991	SS
			corstps	630	9240.4796	6363.0123	SS
			fnc	631	9274.6098	6339.3074	SS
			anchor	632	9283.1158	6322.5533	SS
			endwll**	633	9250.6581	6399.7869	SS
			anchor	634	9234.5488	6391.0191	SS
			@fnd***	635	9317.0705	6321.4454	SS
			fncpost	636	9256.9618	6374.8346	SS
			line*	637	9345.5736	6292.6171	SS
			setip*	638	9416.2355	6495.0740	SS
			line	639	9290.5394	6292.6899	SS
			setip**	640	9376.7099	6404.3795	SS
			myip361	641	9065.9510	6978.6500	SS
			fdhubt8*	642	9482.6228	6516.1536	SS
			fdipin*	643	9507.6695	6454.7045	SS
			cordeck	644	9459.3934	6453.4290	SS
			endfnc	645	9420.6219	6380.8620	SS
			clpath**	646	9397.7360	6392.0101	SS
			clpath**	647	9413.5705	6432.6620	SS
			clpath**	648	9429.9731	6479.5276	SS
			corhse	649	9331.0761	6311.0626	SS
			endfnc	650	9334.7715	6322.0244	SS
			corfnc	651	9314.5858	6306.9339	SS
			facendfc	652	9324.3694	6325.3406	SS
			rrspkchk	653	9376.5197	6350.8786	SS
			ibarchk	654	9402.5896	6307.5550	SS
				655	9376.7249	6404.3729	INT
			D1FNDPK	700	9563.3335	6062.5457	TRA
			EFNDPK*	701	9741.2845	6089.7116	TRA
			D3SETPK	702	9701.6458	6235.3538	TRA
			D2SETPK	703	9419.6208	6346.6195	TRA
			CSETSPK*	704	8834.8772	5811.5024	TRA
			DFNDPK*	705	9335.4032	5970.0608	TRA
			hub	706	9240.1389	6399.3107	TRA
			ipincote	707	9461.9119	6474.7105	TRA
			D4SETPK	708	8981.0606	6678.2818	TRA
			fndpk300	709	8809.5269	7030.2141	TRA
			CORWLL	710	9424.4865	6263.9056	SS
			WLLCHNG	711	9447.3072	6218.4244	SS
			WLLCHNG*	712	9470.1912	6173.8307	SS
			IPINCOTE	713	9537.5949	6171.9796	SS
			PKCOTE	714	9621.5257	6073.9544	SS
			PKCOTE	715	9658.8506	6086.1062	SS
			PKCOTE	716	9697.0458	6076.0243	SS
			FDPINJ&B	717	9719.4958	6221.7357	SS
			FDPIN5/8	718	9719.0556	6221.4392	SS
			IPINCOTE	719	9680.8867	6209.6497	SS
			FDIP***	720	9633.1236	6195.2010	SS
			FNDIP	721	9582.7279	6181.2674	SS
			FNDPKPOL	722	9650.2692	6281.3681	SS
			FDNLENDW	723	9603.2371	6299.7027	SS
			IPINCOTE	724	9583.6472	6268.7005	SS
			FDNLPOL	725	9558.6765	6321.0977	SS
			FDNLPOL	726	9466.5871	6360.5701	SS

JOB #13 777BAMFORD [1766]

Bearing	Distance	Elev	Descrip	Pnt.	Northing	Easting	Type
-----02-15-2025-----				19:11:26-----			D:... \BMHOME17
			sethub	727	9240.1369	6399.3164	TRA
			OVERPIN*	728	9295.3372	6422.0445	SS
			CORHSE	729	9303.0102	6379.2872	SS
			CORWLL**	730	9355.0445	6370.9277	SS
			CORHSE*	731	9336.9943	6349.5929	SS
			IPINCOTE	732	9400.4380	6309.1887	SS
			WLLCHNG	733	9402.4164	6307.7902	SS
			IPINCOTE	734	9382.4442	6346.1174	SS
			IPINCOTE	735	9375.1737	6352.3888	SS
			CRNEWFND	736	9373.9118	6332.5344	SS
			CRNEWFND	737	9384.7529	6311.0910	SS
			FNDPK213	738	9601.2701	6293.3107	SS
			ipchk	739	9154.4406	6352.0212	SS
			ipinf**	740	9334.2471	6219.0023	SS
			fndipin	741	9311.4702	6263.6059	SS
			pole	742	9289.5115	6307.3232	SS
			ipincote	743	9288.7183	6308.1124	SS
			fndipin	744	9265.9096	6352.6436	SS
			ipincote	745	9243.2002	6397.0426	SS
			pole	746	9246.0988	6397.0905	SS
			ipincote	747	9421.9603	6383.0177	SS
			ipin5/8	748	9461.9270	6474.6347	SS
			ipincote	749	9461.9109	6474.7132	SS
			fnc/fnc*	750	9375.7088	6403.6704	SS
			FNDIP***	751	9154.3877	6352.0408	SS
			IPINCOTE	752	9245.1254	6173.5433	SS
			FNDTBAR	753	9290.8472	6084.0953	SS
			CRWLL**	754	9293.2107	5989.7728	SS
			CORFNC	755	9332.2637	5998.2968	SS
			FNDPK110	756	9328.2106	5989.7375	SS
			CRSTNS**	757	9565.4976	6069.7713	SS
			POLE	758	9429.3451	6027.5755	SS
			ipburke	759	8873.8528	6826.0350	SS
			ipincote	760	8851.5058	6870.4732	SS
			pkburke	761	8887.1129	6888.8767	SS
			fndpk	762	9024.5573	6709.5169	SS
			fndpk	763	9061.6587	6675.6848	SS
			fdnlpole	764	9172.9871	6577.1094	SS
			endclfnc	765	9169.3518	6528.1142	SS
			endclfnc	766	9085.7340	6487.5003	SS
			rrspkchk	767	9095.5134	6378.4328	SS
			ipinchk	768	9255.2096	6066.5755	SS
			ipinchk	769	9232.5949	6111.2261	SS
			ipinf**	770	9222.3502	6218.0477	SS
			endclfnc	771	9131.0169	6395.7626	SS
			endclfnc	772	9107.5093	6440.2882	SS
			settkwlk	773	9850.2181	6162.1139	SS
			ipinj\$b*	774	9829.7099	6203.1329	SS
			concbnd*	775	9814.7421	6250.6617	SS
			tbar?	776	9697.7531	6068.5211	SS
			ipburke	777	9056.0513	6953.5995	SS
			endwdfnc	778	9285.8031	6628.1249	SS
			endclfnc	779	9317.5639	6590.0358	SS
			endclfnc	780	9353.0109	6553.0654	SS
			endclfnc	781	9413.8722	6492.3624	SS
			corstep	782	9298.4354	6391.5118	SS
			corpst	783	9304.9182	6388.0373	SS
			corpst	784	9318.9706	6375.7403	SS

JOB #13 777BAMFORD [1766]

Bearing	Distance	Elev	Descrip	Pnt.	Northing	Easting	Type
-----02-15-2025-----19:11:26-----D:...\BMHOME17							
			corstep	785	9323.8203	6368.7830	SS
			catchbas	786	9334.2857	6393.2269	SS
			corhse**	787	9302.9044	6379.2341	SS
			endwll**	788	9346.4230	6378.5523	SS
			endwll**	789	9355.0401	6370.9152	SS
			corprch*	790	9341.1666	6351.2083	SS
			corhse*	791	9336.9670	6349.5800	SS
			deck**	792	9317.0517	6326.0750	SS
			corep	793	9323.9656	6327.0928	TRA
			ep	794	9341.6869	6337.3274	SS
			corep	795	9375.5289	6357.5041	SS
			vin's x	796	9377.9945	6350.6704	SS
			CORHSE**	797	9322.3213	6332.9146	SS
			SETSPK**	798	9327.1537	6329.0580	SS
			B	799	8130.5439	5637.4931	TRA
				800	9563.3947	6062.6724	
				801	9741.3457	6089.8383	
				802	9701.7150	6235.4714	
				803	9419.6948	6346.7366	
				804	9037.5578	6648.0774	INT
				805	9144.1137	6287.4670	INT
				806	8851.5720	6870.5064	INT
				807	8873.8791	6826.0482	INT
				808	9097.8764	6379.6184	INT
				809	9120.3053	6334.9174	INT
				810	9165.1801	6245.4814	INT
				811	9232.5534	6111.2053	INT
				812	9254.9995	6066.4701	INT
				813	9293.4279	5989.8817	INT
				814	9290.8756	6084.1096	INT
				815	9245.8257	6173.8947	INT
				816	9245.8254	6173.8946	INT
				817	9156.0276	6352.8636	INT
				818	9221.8010	6217.6849	INT
				819	9221.8010	6217.6849	INT
				820	9223.4060	6218.5775	INT
				821	9087.9224	6488.5984	INT
				822	9130.9629	6395.8704	INT
				823	9153.9529	6351.9324	TRA
			lc??	824	8938.6648	6786.0702	TRA
				825	9319.3277	6322.2381	INT
			calcor	830	9416.0739	6494.6826	TRA
			calcor	831	9416.0789	6494.6939	TRA
			calcor	832	9320.9710	6451.3198	INT
			calcor	833	9377.2471	6351.2879	TRA
				834	9289.7267	6307.4308	TRA
				835	9244.9889	6396.8653	TRA
				836	9245.0546	6396.8981	INT
				837	9245.0572	6396.8929	TRA
				838	9320.9710	6451.3198	INT
				839	9022.2088	6712.9184	INT
				840	9287.1094	6477.8524	INT
				841	9011.1502	6724.2286	TRA
				842	9010.3434	6723.3078	INT
				843	9376.7171	6351.0422	TRA
				844	9350.6385	6373.7953	INT
				845	9252.1012	6288.5682	TRA
				846	9289.9145	6307.5252	TRA

JOB #13 777BAMFORD [1766]

Bearing	Distance	Elev	Descrip	Pnt.	Northing	Easting	Type
-----02-15-2025-----19:11:26-----D:... \BMHOME17							
				847	9245.0979	6396.9202	TRA
				848	9530.2753	6052.9457	TRA
				849	9379.2151	6354.0114	INT
				850	9402.2007	6308.2007	TRA
				851	9402.9280	6380.9565	TRA
				852	8937.1700	6789.0495	INT
				853	9379.3516	6401.6140	INT
				854	9376.5808	6404.0418	INT
				855	9339.9975	6346.9508	TRA
				856	9280.5402	6353.5710	TRA
				857	9314.4372	6323.9529	INT
				858	9316.1021	6320.6246	INT
				859	9310.2914	6317.7179	INT
				860	9416.0555	6494.6346	TRA
				861	9416.5249	6495.7176	TRA
				862	9296.7108	6421.5672	TRA
				863	9376.9258	6349.5979	TRA
				864	9331.6544	6390.2237	INT
				865	9245.1989	6396.9703	INT
				866	9295.3372	6422.0445	Base D
				867	9245.6072	6396.8414	INT
				868	9289.8579	6307.1649	TRA
				869	9245.5509	6397.4242	TRA
				870	9376.5944	6350.8515	TRA
				871	9289.7283	6307.4617	TRA
				872	9245.0425	6396.9222	TRA
				873	9295.3372	6422.0445	TRA
				874	9376.1224	6402.9898	TRA
				875	9350.4754	6373.7330	INT
				876	9063.7845	6678.1110	INT
				877	9395.6159	6394.5156	INT
				878	9376.1224	6402.9898	INT
				879	9245.6943	6397.2147	INT
				880	9283.0735	6356.4702	TRA
				881	9317.0579	6326.7756	TRA
				882	9378.0716	6351.2340	INT
				883	9245.6070	6396.9999	TRA
				884	9377.3612	6351.2382	INT
				885	9354.4623	6370.2397	INT
				886	9296.2463	6422.5052	TRA
				887	9245.7420	6396.9097	TRA
				888	9295.8895	6422.3244	TRA
				889	9289.6400	6307.0600	TRA
				890	9376.5040	6350.4543	INT
				891	9376.9901	6351.0033	TRA
				892	9290.2506	6307.3609	INT
				893	9376.5040	6350.4543	INT
				894	9333.3657	6217.5634	TRA
				895	9289.5962	6307.1499	TRA
				896	9376.3382	6350.7873	TRA
				897	9376.5046	6350.4550	INT
				898	9376.5055	6350.4560	INT
				899	9245.9899	6397.3156	TRA
				900	9245.7313	6397.1547	TRA
				901	9295.9808	6422.3674	TRA
				902	9290.5779	6307.7746	TRA
				903	9377.4236	6351.4373	TRA
				904	9289.5413	6307.2620	TRA

JOB #13 777BAMFORD [1766]

Bearing	Distance	Elev	Descrip	Pnt.	Northing	Easting	Type
-----02-15-2025-----19:11:26-----D:...\BMHOME17							
				905	9376.3293	6350.8080	TRA
	97.10			906	8472.5676	6350.6959	TRA
				907	9289.7571	6307.3701	TRA
				908	9457.6682	6279.5502	TRA
				909	9377.0814	6351.0464	TRA
				910	9289.7581	6307.3680	INT
				911	9377.3259	6351.3253	TRA
				912	9289.7351	6307.4350	TRA
				913	9289.7660	6307.3719	TRA
				914	9289.9816	6307.4800	TRA
				915	9376.8211	6350.9233	INT
				916	9331.6544	6390.2237	INT
				917	9377.6286	6351.4020	INT
				918	9376.0599	6350.6173	INT
				919	9377.1701	6351.1726	INT
				920	8984.7898	6694.1433	INT
				921	9319.0424	6322.0954	INT
				922	9377.3382	6351.2567	INT
				923	9350.4754	6373.7330	INT
				924	9380.7173	6401.0180	TRA
				925	9378.8842	6401.8180	TRA
				926	9352.6256	6371.8489	INT
				927	9245.1888	6396.6293	INT
				928	9321.1379	6451.3829	INT
				929	9312.0956	6262.7136	TRA
				930	9401.6966	6307.1169	TRA
				931	9295.1929	6422.3321	INT
				932	9324.2532	6324.7020	INT
				933	9296.7108	6421.5672	TRA
				934	9289.5115	6404.4232	TRA
				935	9376.9258	6349.5979	TRA
				936	9378.0940	6350.5146	INT
				937	9350.0253	6354.9094	INT
				938	9296.3462	6422.1118	INT
				939	9355.4174	6370.6783	TRA
				940	9402.9439	6307.3289	INT
			ernie	950	9461.9119	6474.7105	
			ernie	951	9421.9676	6383.0347	TRA
			ernie	952	9467.7633	6362.9659	TRA
			ernie	953	9507.7076	6454.6418	TRA
				954	9321.6977	6452.1298	TRA
				955	9379.1323	6401.8061	INT
				956	9379.7097	6401.5531	INT
				957	9011.0957	6724.2763	TRA
				958	9379.3014	6401.6591	INT
				959	9416.0874	6494.7135	TRA
				960	9376.5810	6404.0426	INT
				961	9416.5253	6495.7184	TRA
				962	9350.2200	6373.9567	INT
				963	9376.3050	6403.4045	TRA
				964	9376.3033	6403.4052	INT
				965	9422.1412	6383.4331	INT
				966	9416.2476	6495.0811	TRA
				967	9350.3788	6373.8176	INT
				968	9289.7669	6307.3505	TRA
				969	9244.9464	6396.7435	TRA
				970	8634.5814	5786.7832	INT
				971	9296.3462	6422.1118	INT

JOB #13 777BAMFORD [1766]

Bearing	Distance	Elev	Descrip	Pnt.	Northing	Easting	Type
-----02-15-2025-----19:11:26-----D:...\BMHOME17							
				972	9296.1713	6422.4616	INT
				973	9372.6466	6294.6579	INT
				974	9378.0940	6350.5146	INT
				975	9378.0940	6350.5146	INT
				976	9378.0750	6351.1458	INT
			KCMINTST	1006	9377.1860	6351.5900	
			KCM(276)	1030	8984.7890	6694.1430	
			KCM(753)	1253	9290.7430	6083.9670	
			KCM(752)	1254	9245.1000	6173.7250	
			KCM(770)	1255	9222.2920	6218.2260	
			KCM(289)	1256	9199.5680	6262.8120	
			KCM(268)	1257	9154.1000	6351.8540	
			KCM(767)	1258	9098.0160	6379.3390	
			KCM(313)	1259	9164.8540	6245.5550	
			KCM(768)	1261	9255.0890	6066.4730	
				1262	9165.3974	6245.0483	INT
				1263	9120.5508	6334.4281	INT
			KCM270)	1264	9085.6590	6484.9110	
				1265	9165.2819	6245.2784	TRA
			INT	1266	9085.6149	6484.9988	INT
			KCM(317)	1267	8829.1570	6916.2410	
			KCM(760)	1268	8852.4780	6871.0880	
			KCM(759)	1269	8873.7600	6826.1340	
	6.64		FNDMYPK	1300	8804.9742	6454.8536	
	8.44		3SETPK	1301	9016.0806	6559.8596	TRA
	6.33		2SETHUB	1302	8904.0171	6506.0227	SS
	16.07		FDCONCBD	1303	8569.7439	6897.3556	SS
	7.82		FNDIPIN	1304	8906.8628	6226.5474	SS
	9.42		2.67	1305	8896.9726	6334.1078	SS
			FNDIP	1306	8852.5021	6423.8429	SS
	9.20		CORWLL	1307	8816.8077	6406.7374	SS
	6.50		FNDSPK	1308	8794.9495	6449.9720	SS
	5.91		CORFNC	1309	8774.8507	6500.5836	SS
	7.32		NLPOLE	1310	8829.0679	6468.0272	SS
			CORFND	1311	8854.8643	6466.9261	SS
	5.90		CORHSE**	1312	8843.8663	6500.8564	SS
	5.91		THRSHLD	1313	8834.4496	6519.8746	SS
	6.22		CORHSE	1314	8824.6431	6538.6050	SS
	5.59		CATCHBAS	1315	8780.5417	6503.1222	SS
	5.22		CATCHBAS	1316	8762.7406	6541.7433	SS
	5.31		CATCHBAS	1317	8787.0386	6542.6912	SS
	5.52		MH	1318	8765.7388	6556.9972	SS
	7.79		MH	1319	8823.4523	6428.1542	SS
	6.33		2SETHUB	1320	8904.0038	6506.0159	TRA
	6.76		OFFSET	1321	9243.7140	6172.8401	SS
			FNDIP**	1322	9154.3392	6352.0502	SS
	10.80		CORFNC	1323	9085.5805	6487.6112	SS
	9.75		IPINERNI	1324	9053.0951	6468.5465	SS
			IPINER**	1325	9030.8815	6513.3898	SS
	9.55		FNDPK***	1326	8981.0014	6678.2937	SS
			FNDIPINE	1327	9245.0328	6173.6158	TRA
	6.37		POLE	1328	8920.8703	6510.0402	SS
	6.30		EDGUBOX	1329	8918.7103	6512.9751	SS
			CORFND	1330	8898.8478	6488.7492	SS
	5.75		BASEIP**	1331	8886.1737	6579.9976	SS
	5.82		SHED	1332	8882.0853	6558.4381	SS
	5.79		SHED	1333	8877.0049	6567.4554	SS
	6.23		CORHSE	1334	8846.2926	6549.6335	SS

JOB #13 777BAMFORD [1766]


Bearing	Distance	Elev	Descrip	Pnt.	Northing	Easting	Type
-----	-----	02-15-2025	-----	19:11:26	-----	-----	D:... \BMHOME17
		6.06	CORSTEP	1335	8857.9309	6536.0357	SS
		6.12	CORHSE	1336	8865.6078	6511.9378	SS
		6.45	THRSHLD	1337	8861.0247	6520.7051	SS
		6.02	POST	1338	8866.0728	6527.9973	SS
		6.03	POST	1339	8872.2436	6515.8235	SS
				1350	8795.9284	6535.4412	TRA
				1351	8829.5634	6468.4062	TRA
				1352	8918.9433	6513.2529	TRA
				1353	8885.3083	6580.2879	TRA

Point#, Start#-End# or G#= 4-

OWNER OF RECORD:
WARREN & PATRICIA BAMFORD
51 WOODSTOCK STREET
HAMPTON, NH 03842
HAMPTON TAX MAP 305 LOT 26
DEED REFERENCE: RCRD 5737-2774
ZONING CLASS: RA, LOT AREA 7500 SF±
REFERENCE RCRD PLAN 01019

LOT IS LOCATED IN FLOOD HAZARD
ZONE AE (EL 9). REF: FEMA FIRM
NO 33015C0439E DATED 05-17-2005

BUILDING PERMIT APPLICATION PLAN
51 WOODSTOCK STREET
HAMPTON, NH*
SCALE: 1"=20' JULY 17, 2017
STOCKTON SERVICES
HAMPTON, NH

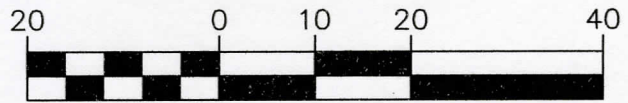

1 INCH = 20 FEET

* A PORTION OF THIS LOT LIES IN
SEABROOK. THIS PLAN APPLIES TO
HAMPTON CONSTRUCTION AND
PERMITTING ONLY.



(FOR SETBACK CERTIFICATION ONLY)



51 WOODSTOCK ST

Location 51 WOODSTOCK ST**Mblu** 305/ 26/ / /**Acct#** 8801**Owner** BAMFORD, WARREN &
PATRICIA**Assessment** \$399,300**Appraisal** \$399,300**PID** 8801**Building Count** 1

Current Value

Appraisal			
Valuation Year	Improvements	Land	Total
2016	\$172,300	\$227,000	\$399,300
Assessment			
Valuation Year	Improvements	Land	Total
2016	\$172,300	\$227,000	\$399,300

Owner of Record

Owner BAMFORD, WARREN & PATRICIA**Sale Price** \$580,000**Co-Owner****Certificate****Address** 51 WOODSTOCK ST
HAMPTON, NH 03842**Book & Page** 5737/2774**Sale Date** 07/27/2016**Instrument** 20

Ownership History

Ownership History					
Owner	Sale Price	Certificate	Book & Page	Instrument	Sale Date
BAMFORD, WARREN & PATRICIA	\$580,000		5737/2774	20	07/27/2016
WOODSTOCK FAMILY TRUST	\$0		PRO-1390		08/17/2008
PHELAN, JOHN E	\$40		4733/0057	1A	10/07/2006
PHELAN, JOHN E & SHIRLEY M	\$0		1594/0199		08/10/1961

Building Information


Building 1 : Section 1

Year Built: 1962
Living Area: 1,050
Replacement Cost: \$198,932
Building Percent Good: 85
Replacement Cost Less Depreciation: \$169,100

Building Attributes	
Field	Description
Style	Raised Ranch
Model	Residential
Grade:	Average
Stories:	1 Story
Occupancy	1
Exterior Wall 1	Vinyl Siding
Exterior Wall 2	
Roof Structure:	Gable/Hip
Roof Cover	Asph/F GlS/Cmp
Interior Wall 1	Drywall/Sheet
Interior Wall 2	K PINE/A WD
Interior Flr 1	Carpet
Interior Flr 2	
Heat Fuel	Gas
Heat Type:	Hot Water
AC Type:	None
Total Bedrooms:	3 Bedrooms
Total Bthrms:	2
Total Half Baths:	0
Total Xtra Fixtrs:	
Total Rooms:	0
Bath Style:	Modern

Building Photo

Building Photo (<http://images.vgsi.com/photos2/HamptonNHPhotos//\00\01\55\57.jpg>)

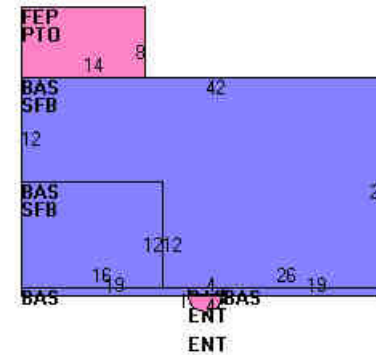Building Layout

Building Sub-Areas (sq ft)			Legend
Code	Description	Gross Area	Living Area
BAS	First Floor	1,050	1,050
ENT	ENTRY	10	0
FEP	Porch, Enclosed, Framed	112	0
PTO	Patio	112	0
SFB	Basement, Semi Fin	1,008	0
		2,292	1,050

Extra Features

Extra Features					<u>Legend</u>
Code	Description	Size	Value	Bldg #	
FPL	METAL PRE-FAB	1 UNITS	\$2,500	1	

Land**Land Use**

Use Code 1010
Description SINGLE FAMILY
Zone RA
Neighborhood 70
Alt Land Appr Category No

Land Line Valuation

Size (Acres) 0.13
Frontage 0
Depth 0
Assessed Value \$227,000
Appraised Value \$227,000

Outbuildings


Outbuildings						<u>Legend</u>
Code	Description	Sub Code	Sub Description	Size	Value	Bldg #
SHD1	SHED FRAME			60 S.F.	\$700	1

Valuation History

Appraisal			
Valuation Year	Improvements	Land	Total
2016	\$172,800	\$227,000	\$399,800
2015	\$119,200	\$187,300	\$306,500
2014	\$119,200	\$187,300	\$306,500

Assessment			
Valuation Year	Improvements	Land	Total
2016	\$172,800	\$227,000	\$399,800
2015	\$119,200	\$187,300	\$306,500
2014	\$119,200	\$187,300	\$306,500


(c) 2016 Vision Government Solutions, Inc. All rights reserved.

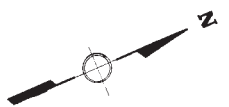

UNDERGROUND FACILITIES, STRUCTURES AND UTILITIES HAVE BEEN PLOTTED FROM AVAILABLE SURVEYS AND RECORDS, AND THEREFORE THEIR LOCATIONS MUST BE CONSIDERED APPROXIMATE ONLY. THERE MAY BE OTHERS, THE EXISTENCE OF WHICH IS PRESENTLY NOT KNOWN.

PLAN 1" = 40'

* ALL SANITARY SEWER MANHOLES WITH RIMS AT ELEV. 11.00' OR LOWER SHALL HAVE WATERTIGHT M.H. FRAMES & COVERS AS SPECIFIED IN SECT. 02575 OF SPECS.

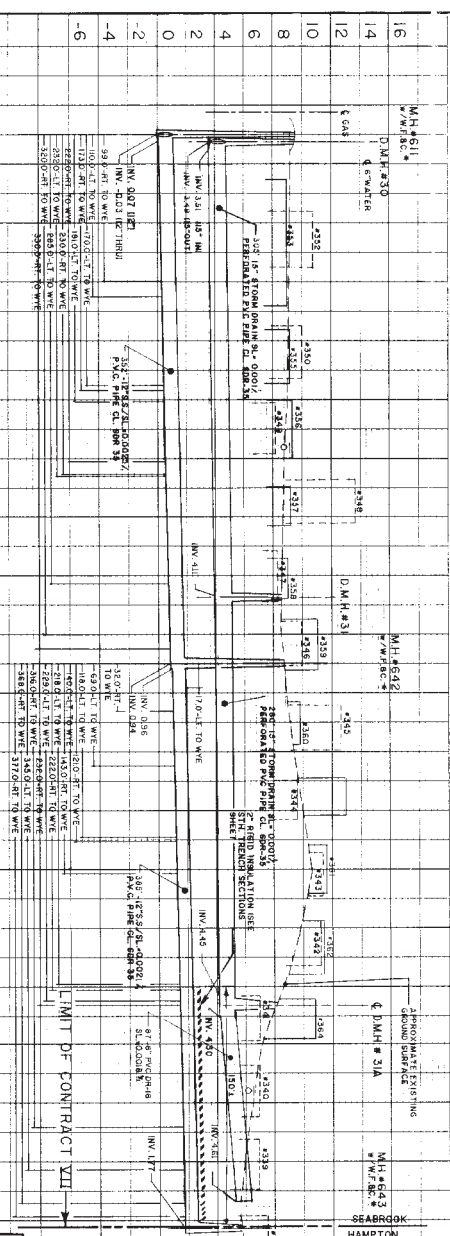

PROFILE



REC'D	DATE	BY	RECORDS	DATE	BY
3	01/26	BH	RECORDS		
2	01/26	BH	RECORDS		
1	01/26	BH	RECORDS		
0	01/26	BH	RECORDS		

RECORD DRAWING



TOWN OF SEABROOK, NEW HAMPSHIRE
SANITARY SEWER CONSTRUCTION

WOODSTOCK STREET

Jones & Beach / Stearns & Wheeler
JOINT VENTURE - CONSULTING ENGINEERS
(DRAIN M.H. NO. 30) (DRAIN M.H. NO. 31)
(MANHOLE NO. 611) (MANHOLE NO. 643)

STATE MAINE - NEW HAMPSHIRE

BK 5737 PG 2774

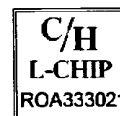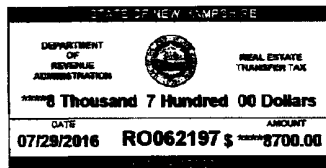

FIDUCIARY DEED

KNOW ALL PERSONS BY THESE PRESENTS: That **KATHLEEN PHELAN**, as **TRUSTEE of the WOODSTOCK FAMILY TRUST**, u/d/t dated October 2, 2006 with a mailing address of 9 Clover Lane, Haverhill, Essex County, Massachusetts 01835 for consideration paid, grants to Warren Bamford and Patricia Bamford, Husband and Wife, as Joint Tenants with Rights of Survivorship of 6 Lyons Farm Road, Haverhill, Essex County, Massachusetts, with

WARRANTY COVENANTS,

the following described premises known as 51 Woodstock Street, Hampton, Rockingham County, New Hampshire and 365 Woodstock Street, Seabrook, Rockingham County, New Hampshire:

One and one-half lots of land on Woodstock Street, consisting of seventy-five hundred square feet (7500) more or less, being Lot 365 and one-half of Lot 366, as shown on Plat 29, Page 3, file #2012, Plan 9174, Rockingham Registry of Deeds, State of New Hampshire.

For further legal description see deed recorded with Rockingham County Registry of Deeds at Book 1594, Page 199.

Subject to all outstanding, easements, covenants, agreement and restrictions of record to the extent that the same are still in force and applicable.

Meaning and intending to convey the same premises conveyed to **JOHN E. PHELAN** by deed of **SHIRLEY M. PHELAN**, dated October 2, 2006 and recorded in the Rockingham County Registry of Deeds at Book 4733, Page 0057.

JOHN E. PHELAN is deceased as of October 17, 2006. Death certificate is to be recorded herewith. Property identified as located in Seabrook Beach, passed into trust through Rockingham County Probate Court, Docket No. 2006-1390.

For further description of 51 Woodstock Street, Seabrook, New Hampshire see Hampton Map Lot #305-26 and Seabrook Map-Parcel 20-365.

032768

2016 JUL 29 AM 11:21


ROCKINGHAM COUNTY
REGISTRY OF DEEDS

BK 5737 PG 2775

Grantor states that this is neither Homestead Property of the Grantor nor any beneficiary of the Woodstock Family Trust.

Executed this 27th day of July, 2016.



Witness: Ariel N. Casey

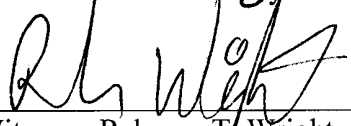
Witness: Rebecca T. Wright



KATHLEEN PHELAN, Trustee of the
Woodstock Family Trust

STATE OF NEW HAMPSHIRE
COUNTY OF ROCKINGHAM


On the 27th day of July, 2016, before me, the undersigned officer, personally appeared **KATHLEEN PHELAN**, Trustee of the Woodstock Family Trust known to me (or satisfactorily proven to be), the person whose name is subscribed to the within instrument, and acknowledged that she did execute the same for the purposes therein contained.

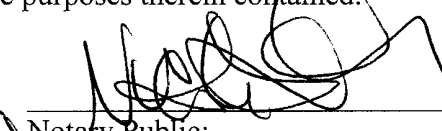
Notary Public:
My Commission Expires:

NICOLE L. NOLAN, Notary Public
My Commission Expires October 15, 2019

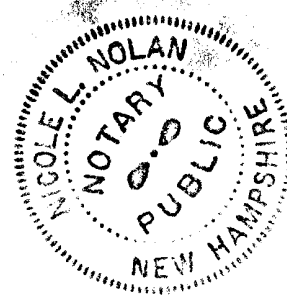

2005 SEP 27 AM 11:14 070498

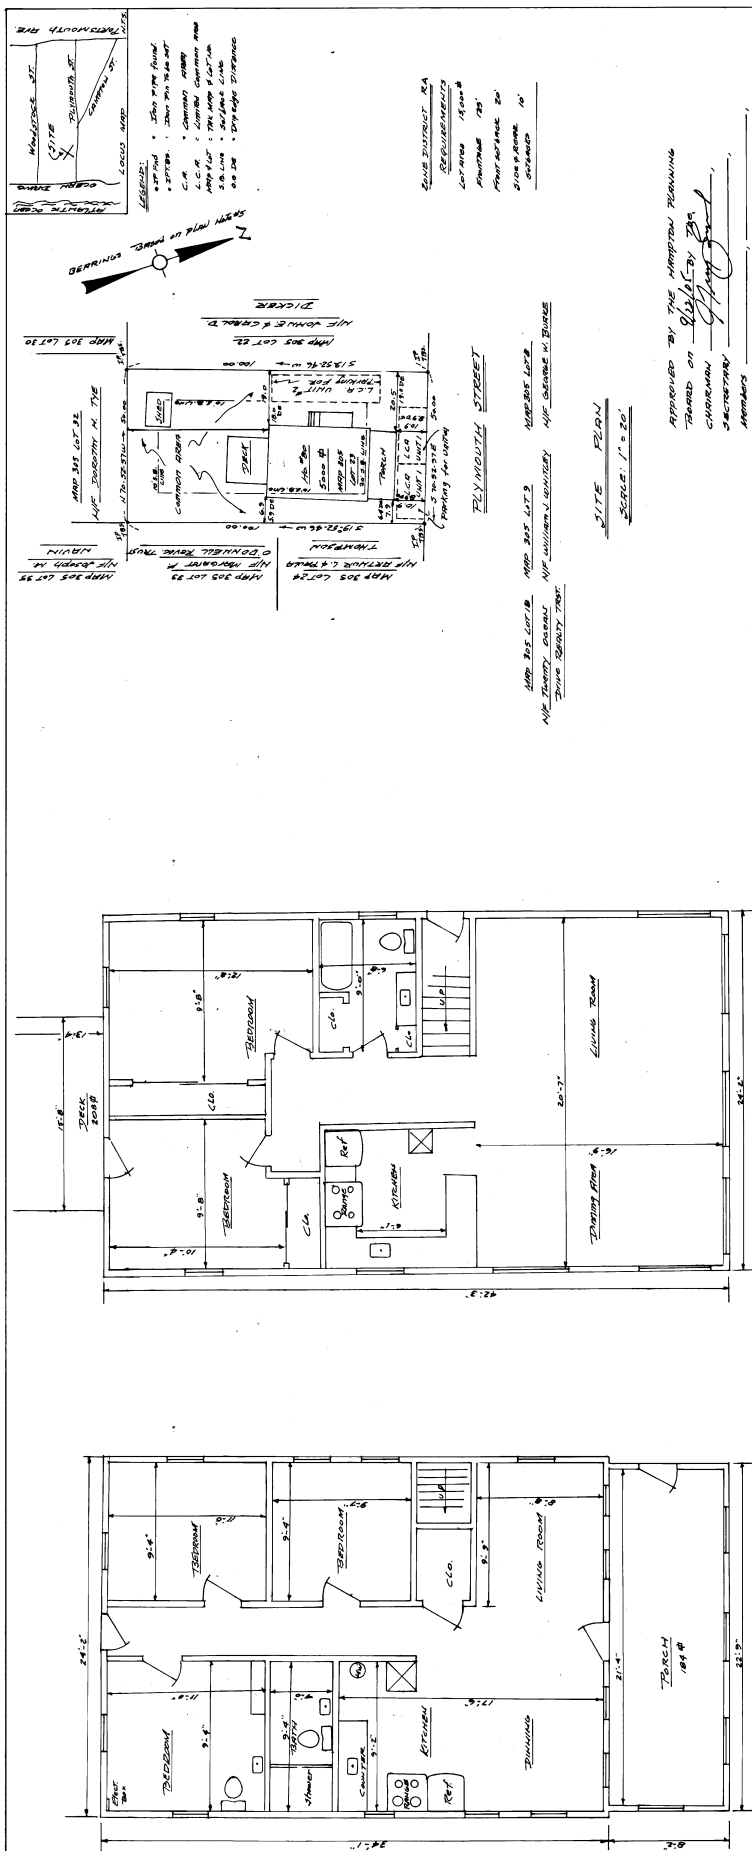

SECOND FLOOR PLAN

FIRST FLOOR PLAN

- NOTE:**
1. This property survey is based on a reference to the 150' TYP. ROAD and 150' TYP. ROAD.
 2. All units on this property are served by the 150' TYP. ROAD and 150' TYP. ROAD.
 3. No easements have been granted for this property.
 4. Property located in the 150' TYP. ROAD and 150' TYP. ROAD.
 5. Reference plans are not to be construed as a representation of the property.
 6. Construction lines are not to be construed as a representation of the property.
 7. This property is located in the 150' TYP. ROAD and 150' TYP. ROAD.
 8. This property is located in the 150' TYP. ROAD and 150' TYP. ROAD.
 9. This property is located in the 150' TYP. ROAD and 150' TYP. ROAD.

I HEREBY CERTIFY THAT THIS PLAN, MAP, AND SURVEY IS A TRUE AND CORRECT REPRESENTATION OF THE LAND AND BUILDING THEREON, AND THAT I HAVE NOT BEEN COMPENSATED FOR THIS SURVEY BY ANY OTHER PARTY.


REGISTERED LAND SURVEYOR
WILLIAM H. BROWN
150' TYP. ROAD

OWNER OF RECORD
REAR J. BROWN
150' TYP. ROAD

NO.	DATE	REVISION DESCRIPTION	BY
1	9-10-17	150' TYP. ROAD	WILLIAM H. BROWN
2	9-10-17	150' TYP. ROAD	WILLIAM H. BROWN
3	9-10-17	150' TYP. ROAD	WILLIAM H. BROWN
4	9-10-17	150' TYP. ROAD	WILLIAM H. BROWN
5	9-10-17	150' TYP. ROAD	WILLIAM H. BROWN
6	9-10-17	150' TYP. ROAD	WILLIAM H. BROWN
7	9-10-17	150' TYP. ROAD	WILLIAM H. BROWN
8	9-10-17	150' TYP. ROAD	WILLIAM H. BROWN
9	9-10-17	150' TYP. ROAD	WILLIAM H. BROWN
10	9-10-17	150' TYP. ROAD	WILLIAM H. BROWN

D-33081

Map by NH GRANIT

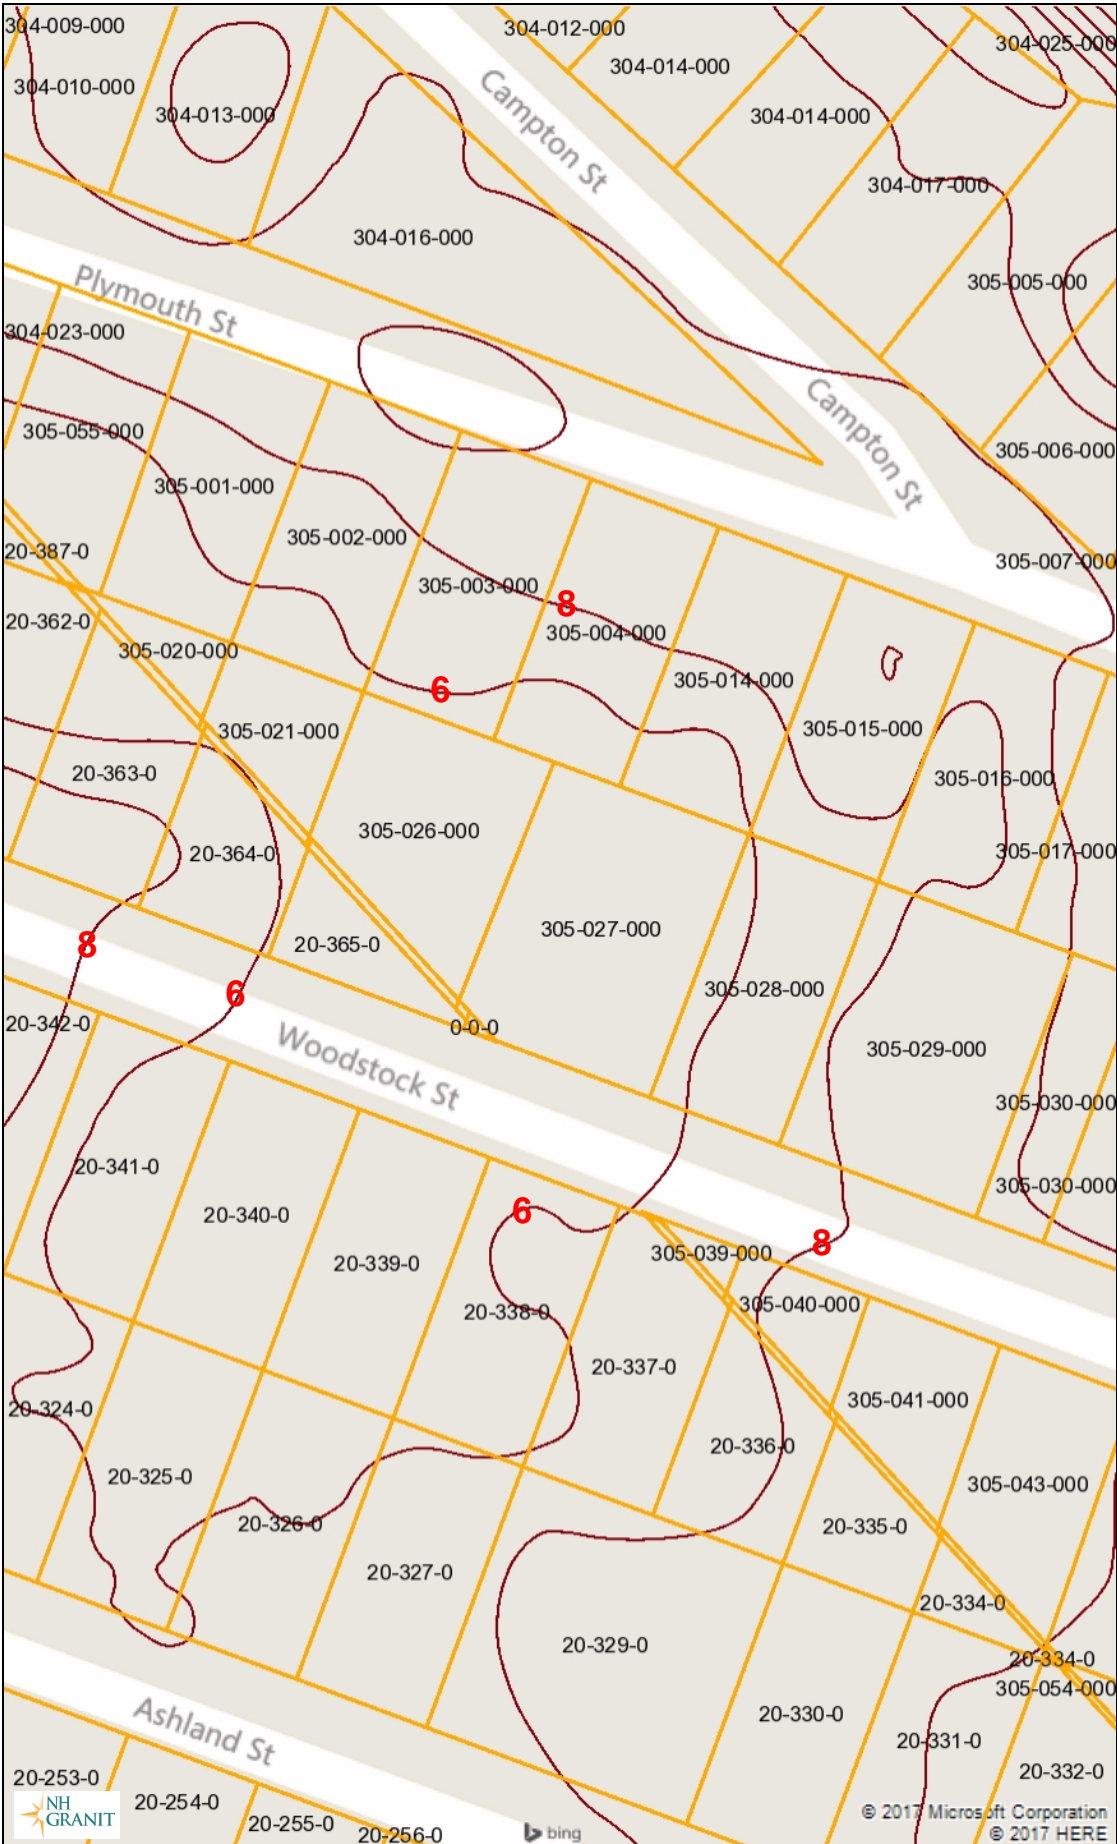

Legend

- Polygons
- LiDAR Derived 2-foot contour

Map Scale
1: 812

1: 812 

© NH GRANIT, www.granit.unh.edu

Map Generated: 6/22/2017

Notes




in RH F20
Rear 10

need to 4/14/2017

house on
slab

10 side
(26)

Verify if survey
needed
and
what
Kevin will
want
forever
certs

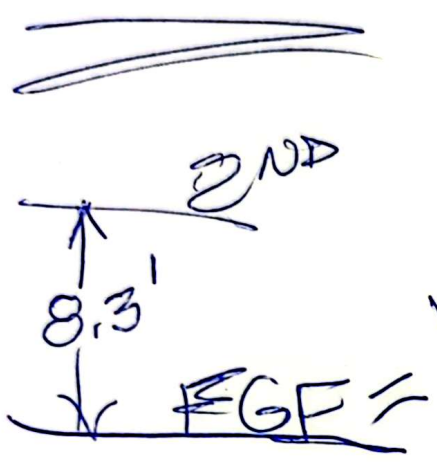

Deed Address
51 Woodstock
Hampton

Hampton
did bldg
permits
Mark Fiscel
Haverhill

wants to build
detached
garage
w/ deck on it w/ use upstairs
connect w/ use
next door
recently
rebuild
Seabrook
permit

10-12-19
6-11-19
36




April 24, 2017

Hampton, NH

1 inch = 134 Feet

0 134 268 403


www.cai-tech.com

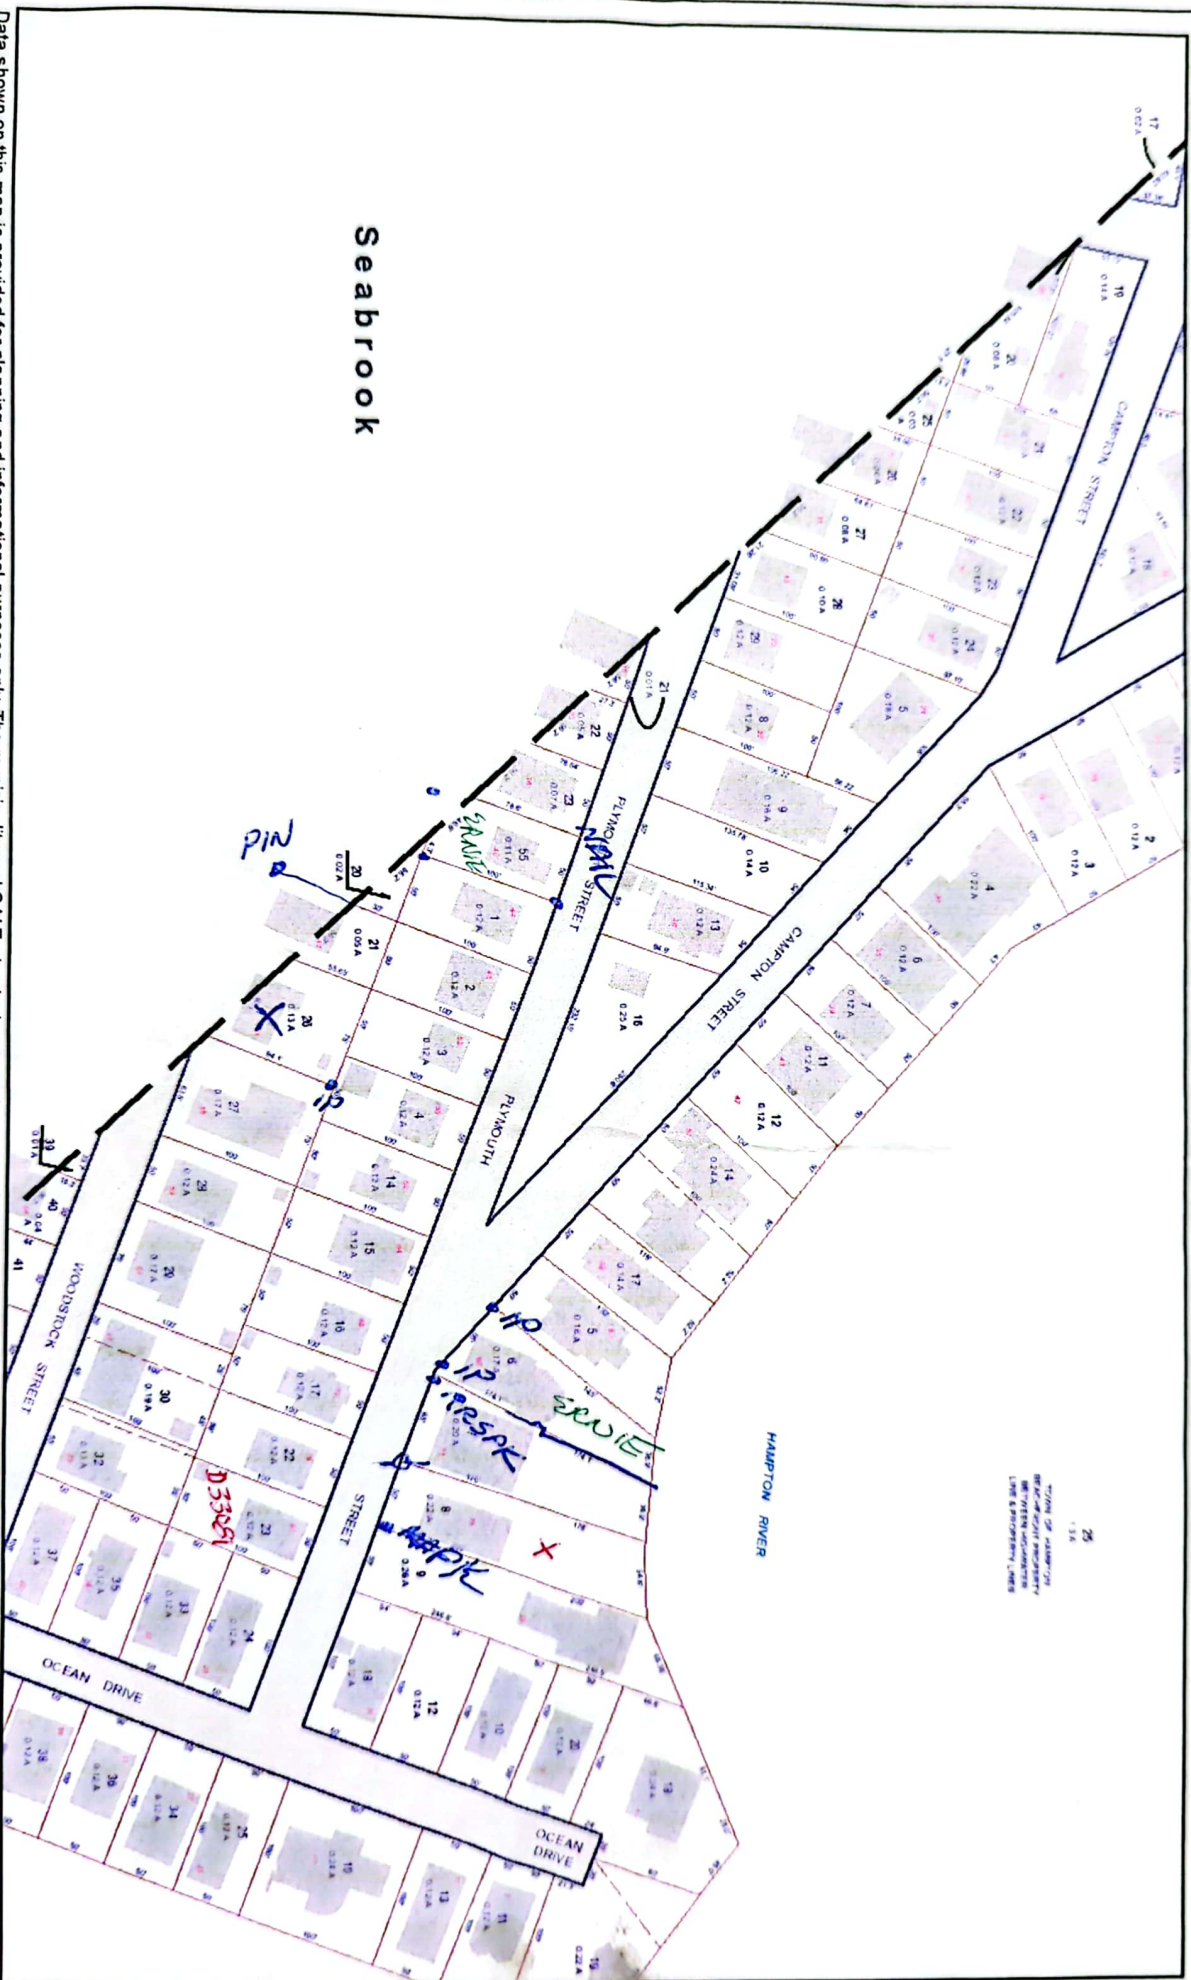

Data shown on this map is provided for planning and informational purposes only. The municipality and CAI Technologies are not responsible for any use for other purposes or misuse or misrepresentation of this map.

ADDIT

80 Plymouth
Plan by Millennium
Proj E151747
9/23/2015
Conjalone

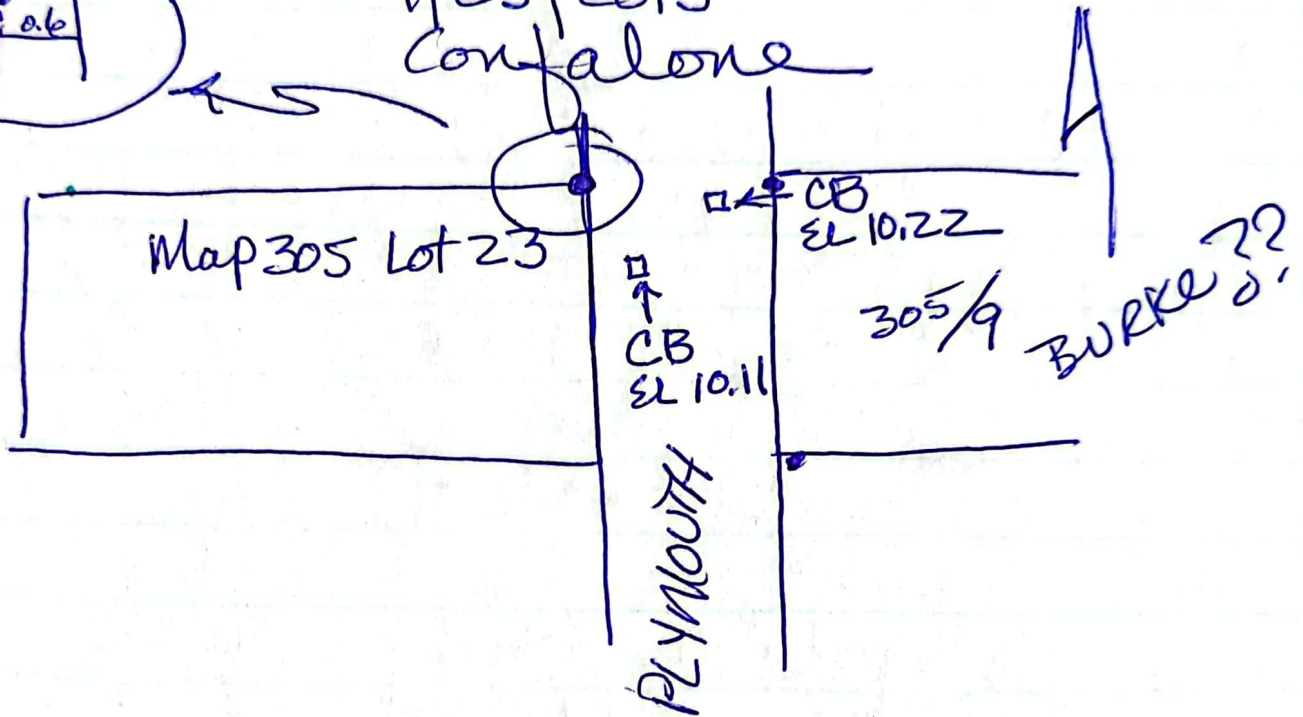

364 Woodstock - I have
IN PIECES - Millennium


FRA

THE CERTIFICATIONS SHOWN HEREON ARE INTENDED
TO MEET REGISTRY OF DEEDS REQUIREMENTS AND
ARE NOT A CERTIFICATION TO TITLE OR OWNERSHIP
OF PROPERTY SHOWN. OWNERS OF ADJOINING
PROPERTIES ARE ACCORDING TO CURRENT TOWN/CITY
ASSESSORS' RECORDS.

I CERTIFY:

THAT THIS ACTUAL SURVEY WAS MADE
ON THE GROUND IN AUGUST OF 2015.

THAT THIS SURVEY CONFORMS TO THE
REQUIREMENTS FOR ACCURACY FOR
N.H. URBAN SURVEY.

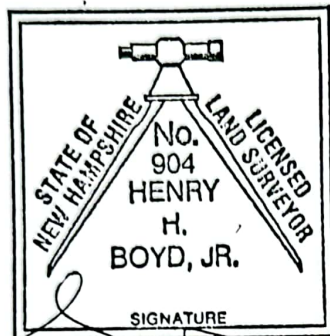

LICENSED LAND SURVEYOR

DATE

08-04-2015

AS-BUILT PLAN

IN

SEABROOK & HAMPTON, NH

SHOWING

AN EXISTING NEW FOUNDATION

AT 364 WOODSTOCK STREET

(ASSESSORS MAP 20 LOT 364/MAP 305 LOT 21)

RECORD OWNERS


V. SCOTT FOLLANSBEE REVCOABLE TRUST

V. SCOTT FOLLANSBEE TRUSTEE

1"=20'
apr 3 2015
PROJ - E-141656
sheet 1 of 2

2670074

STREET

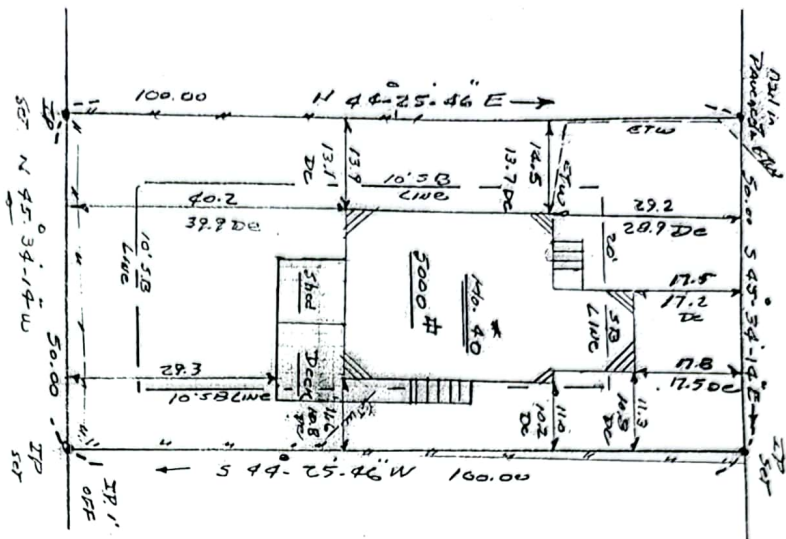

NOTE:

1. PROPERTY SURVEY BASED ON A RANDOM SURVEY WITH A CLOSURE OF GREATER THAN 1 IN 10,000.
2. PROPERTY SHOWN ON FEMA MAP 330132 Parcel 939 of 261 APRIL 17, 2005 Flood ZONE RFE EL. 9. 6' IN BUILDING ZONE. R.R. FRAMINGO 125' 15,000th ACES, FRONT SETBACK 20', SIDE SETBACK 10'. & REAR 10'.

LEGEND:

- I.P. Fnd = Iron pipe found
- IP 50T = Iron P.W. SET
- ~~IP 50T~~ = Fence
- MAP 4 LOT = TAX MAP # LOT 110.
- S.B. LINE = SET BACK LINE
- O.O.B.E. = DNP edge DISTANCE



EXISTING CONDITION PLAN

For

THAMAS V. F. BARRABARR

WALSH

40 PLYMOUTH STREET

MEMORANDUM A.D. 14

DATE: 10/20/2014

MAP 305 LOT 55

E.J. COTE & ASSOCIATES INC


LAND SURVEYORS
TEL. 926-4378

36 PNU's 4 PNU's

LA 94-107-Sub. N.H. 03892 FILE NO. 2-168-1623



PLYMOUTH

STREET

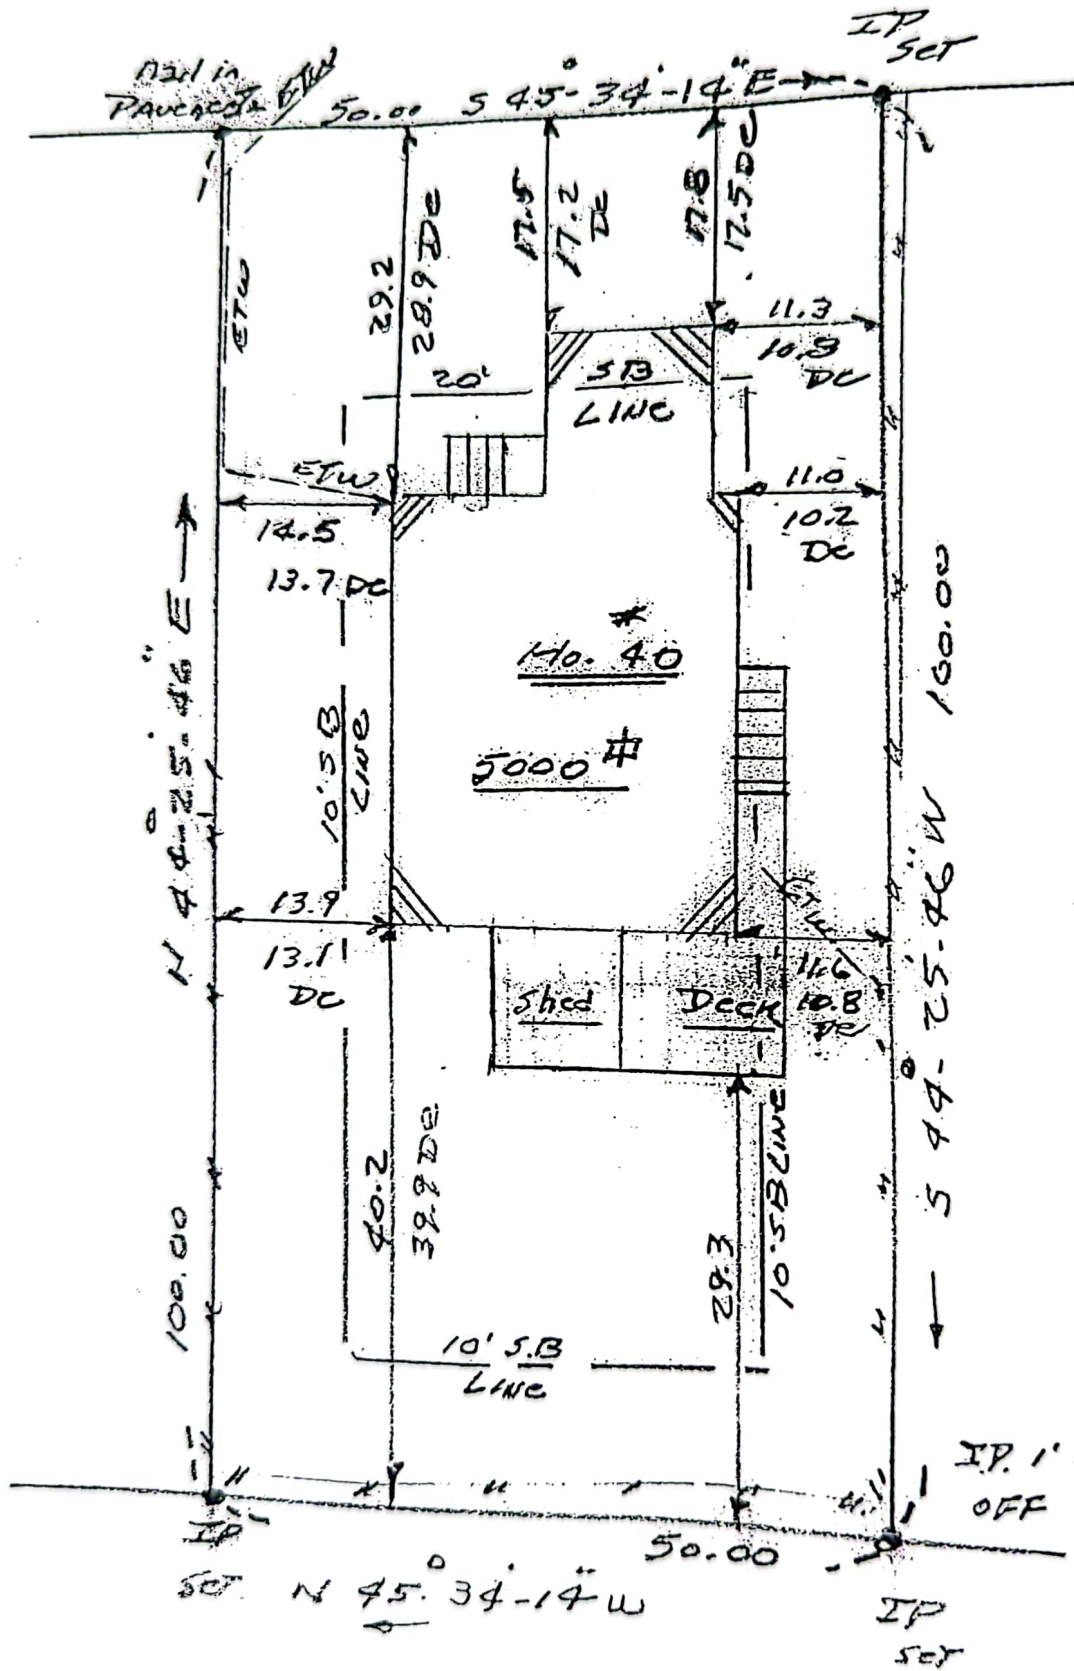

MAP 305 LOT 16 PLYMOUTH STREET

MAP 305 LOT 17

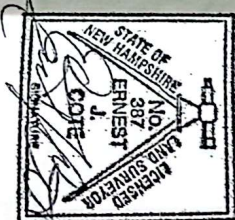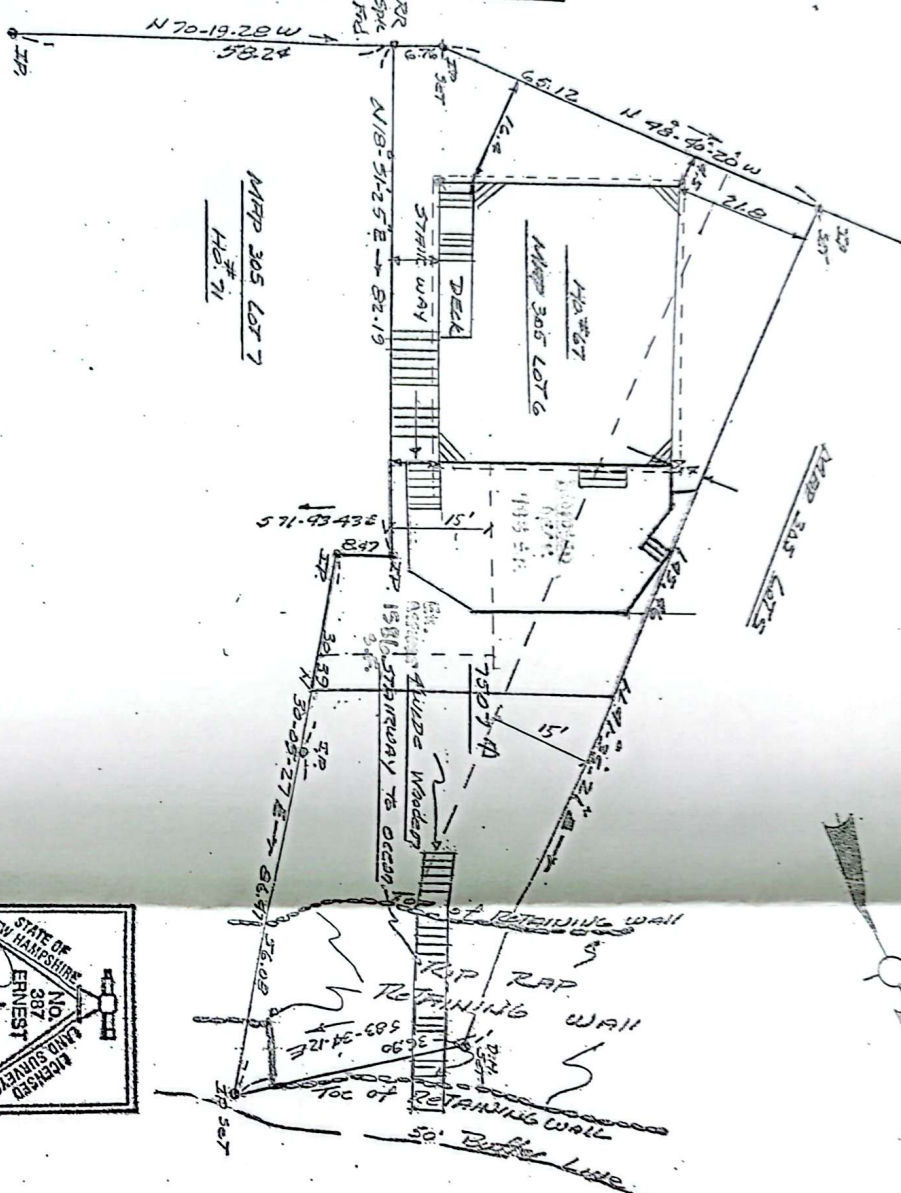

REvised: 9/29/2010 Corrected STAIRS down

Legend:

- " IP 1" and 2" Iron Pipe found
- " IP 6" and 8" Iron Pipe found
- " IP 12" and 14" Iron Pipe found
- " IP 18" and 20" Iron Pipe found
- " IP 996" and 998" Iron Pipe found
- " IP 1000" and 1002" Iron Pipe found

DRIVE LANE
Revised 9/29/2010
HIGH TIDE LANE
Revised 9/29/2010
N.H. 2nd (Cape Fear)

PLAN OF LAND

FOR

THOMAS GRANDMANSION

67 PLYMOUTH STREET

HAIRPTON, N.H.

SCALE: 1" = 20' AUGUST 29, 2010

THAN MAP 305 LOT 6

E.J. COTE & ASSOCIATES INC.

LAND SURVEYORS TEL. 926-4878

36 HANUS LAURE

HAIRPTON, N.H. 03842 PLAN No. 2-125-5660

AUG 31 2010

Bay Street

341	KOCHMAN, PHIL	SEABROO 234	BRISTOL ST	STAKE, PLOT PLAN, EL CERT
387	MARTINEN, HORST	SEABROO 235	BRISTOL ST	ELEV CERT
650	STACK FAMILY TRUST	SEABROO 92	CONCORD ST	SURVEY, CANCELLED
349	WOLF, NANCY	SEABROO 151	FRANKLIN ST	ZBA PLAN, STAKE LOT
389	NOWOSWIAT, DAVE	SEABROO 145	FRANKLIN ST	SURVEY/ PLAN RECORDING
759	LEONE, PAUL	SEABROO 137	FRANKLIN ST	EL CERT, PERMIT PLAN ETC
474	HYDER, GRACE	SEABROO 8	GROVELAND	EL CERT, SURVEY?
21	O'DONOGHUE, MARGARET	SEABROO	MANCHESTER ST	SEPTIC DESIGN REPLACEMENT
353	KEANEY, DANIELLE	SEABROO 526	MANCHESTER ST	CANCELLED
365	MORIARTY	SEABROO 522	MANCHESTER ST	LOCATION PLAN, STK
354	KUENZLER, MIKE	SEABROO 20	NEWBURY STREET	STAKE & PLOT PLAN
305	REITANO, MARIAN	SEABROO 560	OCEAN BLVD	WETLANDS PERMIT
382	RILEY, JOHN	SEABROO 154	OCEAN BLVD	EASEMENT PLAN
517	NORTHWAY BUILDERS	SEABROO	OCEAN BLVD	STAKE BUILDING, EL CERT
560	DEGEORGE, MICHAEL	SEABROO	OCEAN BLVD REAR	CONDO CONVERSION
672	DALY, CAMILLE	SEABROO 67,71	OCEAN DRIVE	ELEV CERTS
157	CAREY, PATRICK	SEABROO	PORTSMOUTH AVE	SURVEY
554	COSTELLO, JANE	SEABROO 307	PORTSMOUTH AVE	SURVEY, ELEV CERT
674	SHOUKIMAS, PETER	SEABROO 124,125	PORTSMOUTH AVE	SURVEY, ELEV CERT, PERMITS
136	CAREY FAMILY TRUST	SEABROO	ROUTE 1A LAWRENCE	SURVEY
330	CAREY, MAUREEN	SEABROO 179	TILTON ST	STAKE LOT?
592	BOTOS, JOANNE	SEABROO 360	WOODSTOCK ST	ELEV CERT

Hampden
494 Seama
361 Burke

HSE 1200[±]
GAR 582

1031
112
1443
84


1800


1860
1281
3141

DRAWN BY:
MARTHA MACINNIS
58 REGENT AVE.
BRADFORD, MA. 01835
(978)374-8719

PROPOSED NEW GARAGE
BAMFORD RESIDENCE
50 WOODSTOCK STREET
HAMPTON, NH

JULY 11, 2017

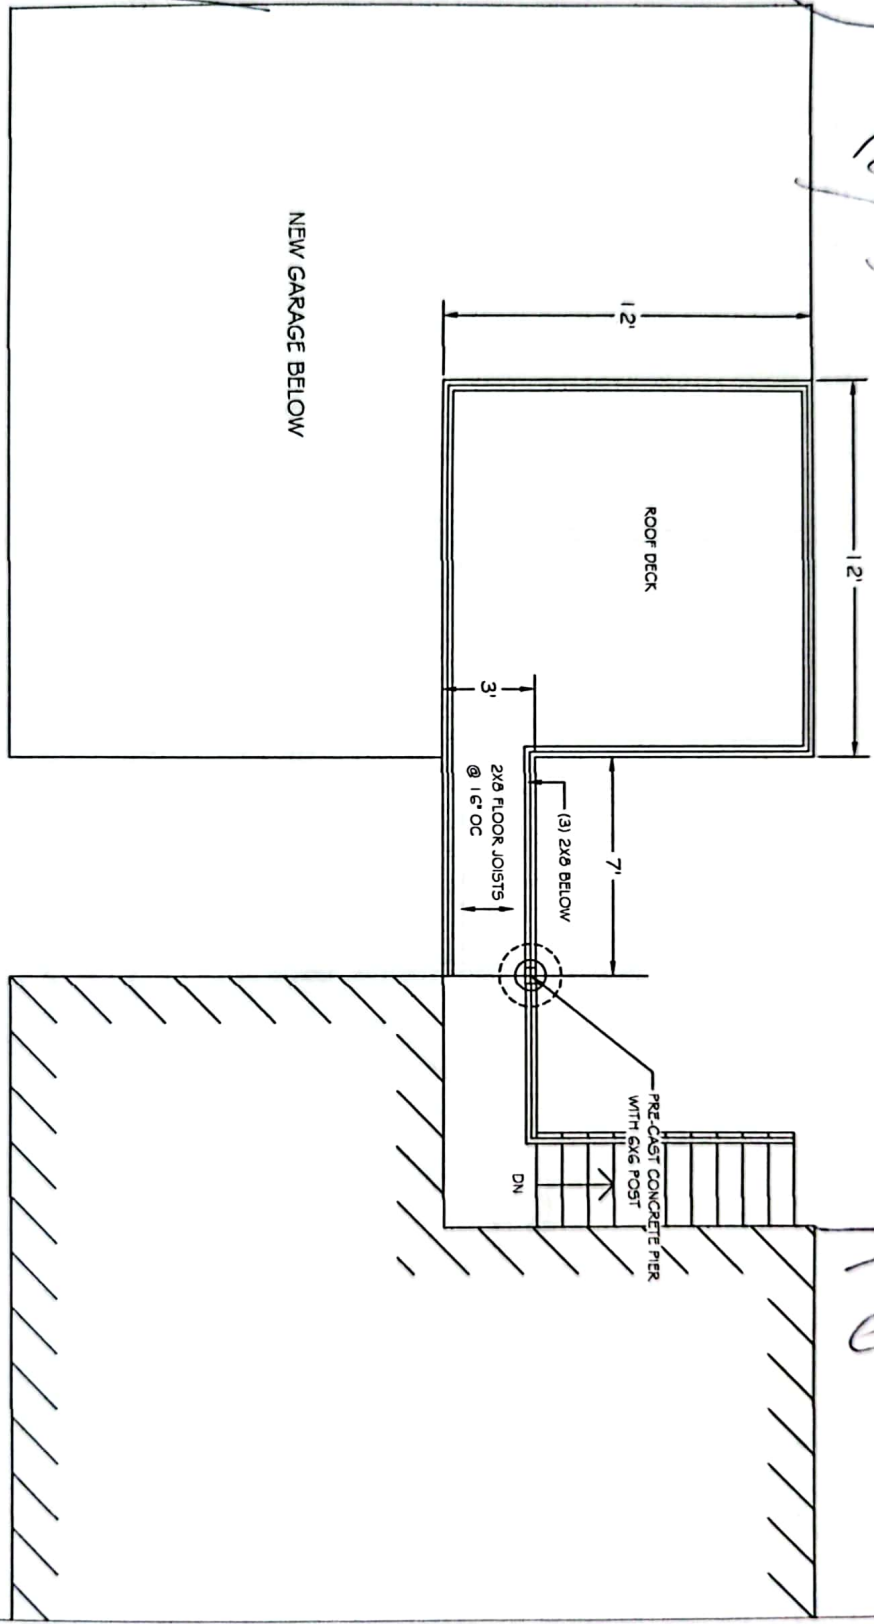

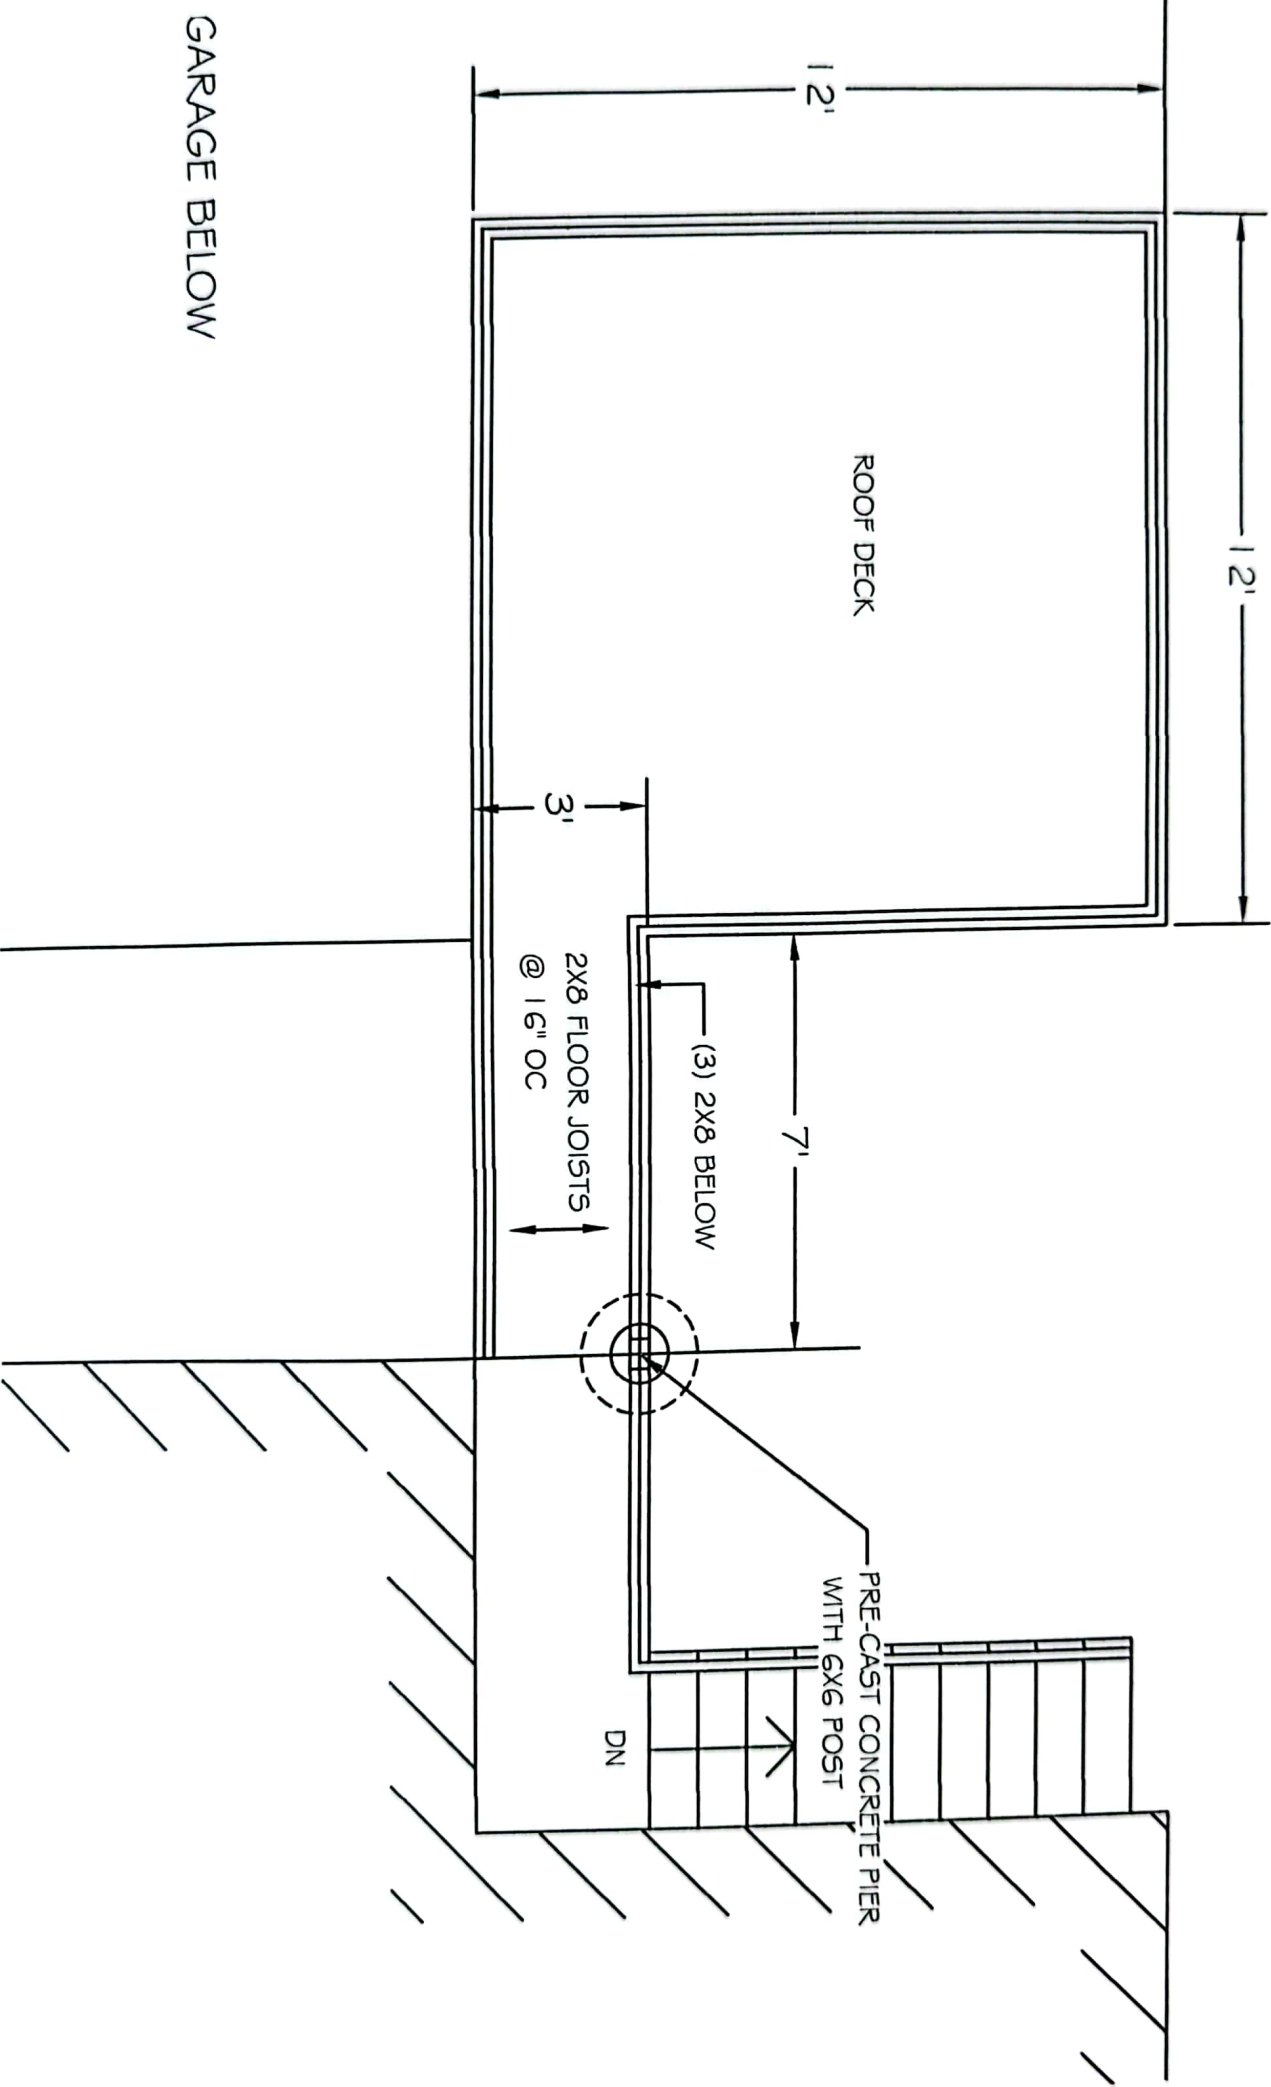

GARAGE BELOW

Stockton Services
PO Box 1306
Hampton, NH 03843-1306
603 929-7404

Tricia and Warren Bamford
c/o Marc Fiscel
New England Custom Carpentry LLC
819 Broadway
Haverhill, MA 01832

Statement 07/19/17

Locus: 51 Woodstock Street, Hampton, NH

Work to Date.
Lot survey, Building Permit Plan. \$ 1000.00

Balance due \$ 1000.00

Thank you.

Tocky

NO
ELEV
CERT